

APPLICATION FOR PERMIT TO TAP SEWER

(Print or Type)

Owner Mr. M. Delbert Oberhouse NO. _____
Address 1207 Bay Reynolds BLDG. PERMIT _____
Contractor J. J. Baker PERMIT FEE \$ _____
Address _____ Tel. 758-3162 DATE PAID _____
for office use only

LOCATION OF CONNECTION

Street and No. 4147 1/2 W. 80th St., W.D.S. Sanitary Storm
Lot No. 26 Subdivision 2nd MARYDOWNS RD Size of Tap _____
Size and Type of Sewer 4" PVC ALL WORK MUST BE INSPECTED

I certify that the sewer will be used only as indicated and no other Drainage will be connected.
Date July 12, 1979 Signature Delbert Oberhouse owner-builder-agent
do not write below this line


INSPECTION RECORD

Date Inspected 7-12-79 Size and Type of Sewer 4" PVC
Location SIDE TO REAR Depth SEE DWG Type of Test _____
Inspected and Approved By: Bruce Weir Inspector Date 7-12-79
Additional Information SEPTIC TANK FILLED W/ STONE

Send copy to: DELBERT OBERHOUSE

SKETCH OF INSTALLATION



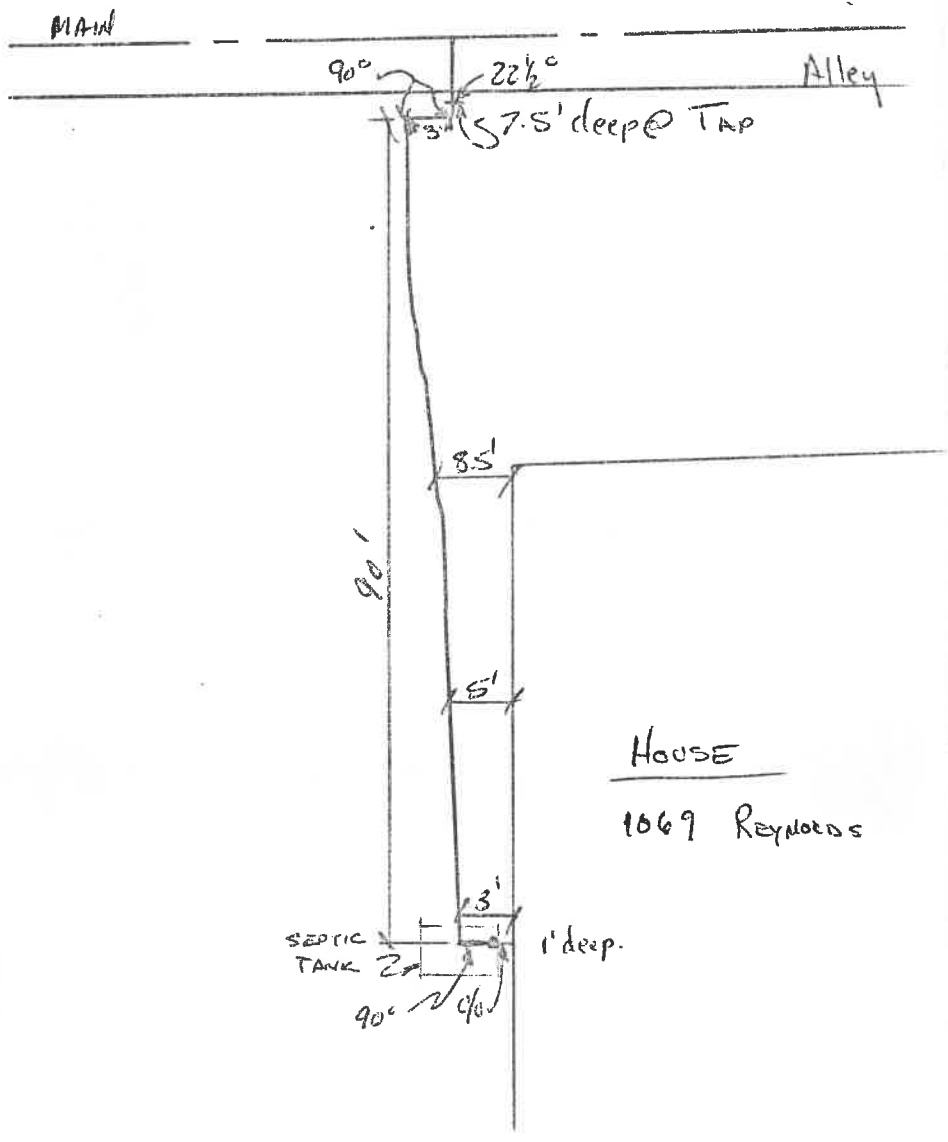

A north-south orientation is indicated by a horizontal line with "N" above it. Below this line, the street names "REYNOLDS" and "ST" are written.