

SEWER TAPPING PERMIT

Issued by

The City of Napoleon Engineering Dept.

253 West Riverview Ave. Napoleon, Ohio 43545 Pn. 592-4010

Entry No. \_\_\_\_\_

Permit No. SA0158 Issued 2-8-91 Build. Permit No. \_\_\_\_\_

Job Location 1012 E. Riverview

Lot \_\_\_\_\_

Issued By Brent D. Dammann sub div. or legal disc.

Owner Chris Pepper Pn. \_\_\_\_\_

Address 1012 E Riverview

Agent Jerry Glanz Pn. \_\_\_\_\_

Address \_\_\_\_\_

Permit Fee \$ 55.00

Street Bond \$ \_\_\_\_\_

Date Paid 2/7/91 55.00

for office use only

WORK INFORMATION

Sanitary Sewer Tap Repair + replace Size of Tap 4" Size and Type of Sewer 4" Street to be Opened

Storm Sewer Tap Repair + Replace Size of Tap 6" Size and Type of Sewer 6" Street to be Opened

Street opening Agreement Approval Date \_\_\_\_\_ Opening Bond Fee (Set by Engineer) \_\_\_\_\_

READ AND SIGN BELOW; The undersigned hereby agrees complete the work described above and to make use of said sewers only as allowed by and in strict accordance with all applicable provisions of The Napoleon Engineering Dept. Rules and Regulations, The Napoleon Standard Specification for Water Main, Sanitary Sewer and Storm Sewer Construction and other Pertinent Sections of the Napoleon Code of Ordinances.

Date 2-7-91 Signature of Applicant Jerry Glanz Permit not valid without signature

INSPECTION RECORD

Date Inspection is made 2-8-91 Size and Type of Sewer 6" vit to be completed by the Field Inspector

Location N of C/B Depth 5'9" south Type of Test \_\_\_\_\_ Additional Information See Reverse  
8' north

Date 2-8-91 Inspected By Brent D. Dammann signature of inspector

Sketch Of Installation on Back or Attached


PAID

FEB 07 1991


CITY OF NAPOLEON

AA1

1012 E. Riverview

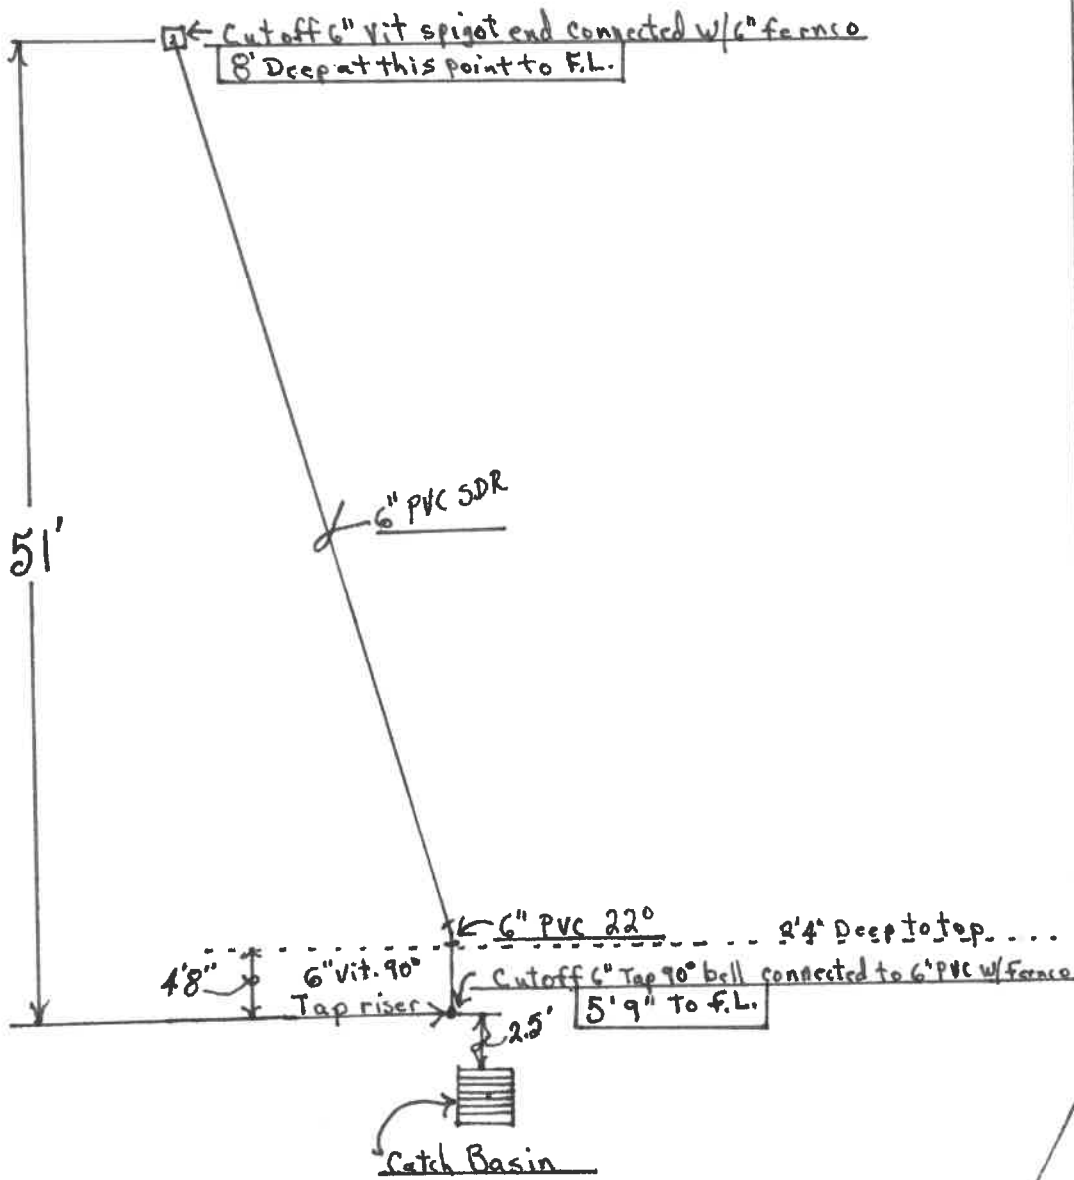

East Riverview

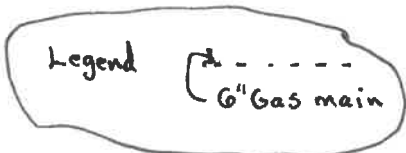

Scale 1" = 10'

SEWER TAPPING PERMIT

Issued by

The City of Napoleon Engineering Dept.

253 West Riverview Ave. Napoleon, Ohio 43545 Pn. 592-4010

Entry No. \_\_\_\_\_

Permit No. \_\_\_\_\_ Issued 2-8-91 Build. Permit No. \_\_\_\_\_

Job Location 1012 E. Riverview

Lot \_\_\_\_\_ sub div. or legal disc.

Issued By Burt Dammann

Owner Chris Pepper Pn. \_\_\_\_\_

Address 1012 E Riverview

Agent Jerry Glanz Pn. \_\_\_\_\_

Address \_\_\_\_\_

Permit Fee \$ 55.00

Street Bond \$ \_\_\_\_\_

Date Paid 2/7/91 55.00

for office use only

WORK INFORMATION

Sanitary Sewer Tap Repair + replace Size of Tap 4" Size and Type of Sewer 4" Street to be Opened

Storm Sewer Tap Repair + Replace yes no Size of Tap 6" Size and Type of Sewer 6" Street to be Opened

Street opening Agreement Approval Date \_\_\_\_\_ Opening Bond Fee (Set by Engineer) \_\_\_\_\_

READ AND SIGN BELOW; The undersigned hereby agrees complete the work described above and to make use of said sewers only as allowed by and in strict accordance with all applicable provisions of The Napoleon Engineering Dept. Rules and Regulations, The Napoleon Standard Specification for Water Main, Sanitary Sewer and Storm Sewer Construction and other Pertinent Sections of the Napoleon Code of Ordinances.

Date 2-7-91 Signature of Applicant Jerry Glanz  
Permit not valid without signature

INSPECTION RECORD

Date Inspection is made \_\_\_\_\_ Size and Type of Sewer \_\_\_\_\_ to be completed by the Field Inspector

Location \_\_\_\_\_ Depth \_\_\_\_\_ Type of Test \_\_\_\_\_ Additional Information \_\_\_\_\_

Date \_\_\_\_\_ Inspected By \_\_\_\_\_ signature of inspector

Sketch Of Installation on Back or Attached

PAID

FEB 07 1991


CITY OF NAPOLEON

AA-1

Reconnect to existing 6" vit.  
6" vit. to 6" PVC  
Ferno 8' Deep

Existing  
3/4" Water Service  
in same trench

6" Gas Main  
2'4" to top

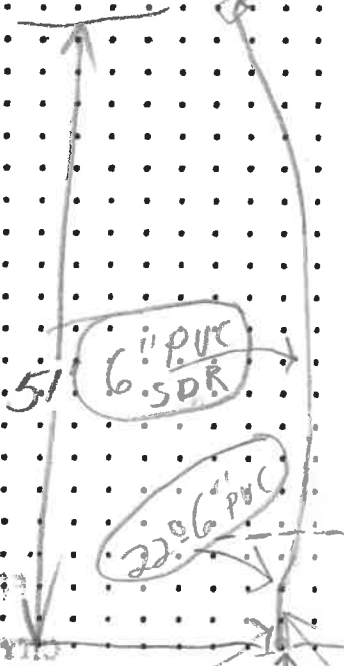

PLAN

100' TO 8' 11"  
10' TO 10' 10"

6" vit 90° off top

25" C/B

5'9" to F.L.