

City of Napoleon, Ohio
Water Department
New Service Connection

INSIDE

METER

Old

New

Service No. _____

Permit No. _____

Lot No. _____ of _____

_____ Addition

Date _____

Lot Owner _____

Lot Fronts

_____ ft. on _____ St.

and _____ ft. on _____ St.

Tapped 12 " TRAW main on North side of E Riverview St.,

between Filmore St. and Commerce Dr St.

No. of ferrules 1 / 1 Size of ferrules 2" ACROSS ROAD / 1" off tee of 3

Connection - long or short _____

156' west hydrant 192)


Distance from _____ corner of) 156'

Valve)

_____ St. and _____ St.

Distance from street main to stop cock box - 60 Ft.

Jerry H. Rudge

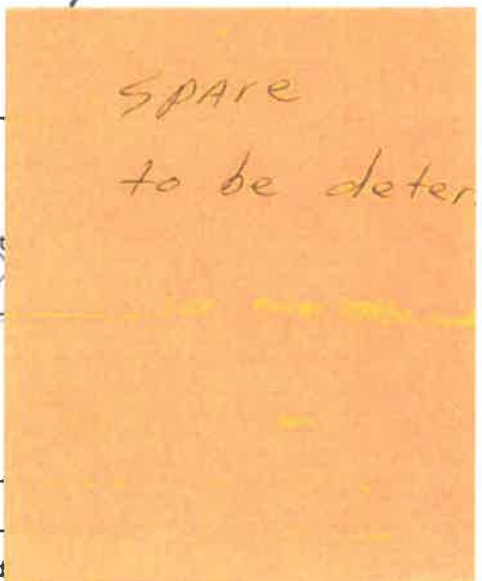

City of Napoleon, Ohio
Water Department
New Service Connection

INSIDE

METER

Service No. _____

Permit No. _____

Lot No. _____ of _____

_____ Addition

Date _____

Lot Owner Escape room

Lot Fronts

_____ ft. on 535 E Riverview St.

and _____ ft. on _____ St.

Tapped 12 " TRAW main on North side of E Riverview St.,

between Filmore St. and Commerce Dr St.

No. of ferrules 1 Size of ferrules 3/4

Connection - long or short long

100' west hydrant 192)

Distance from _____ corner of) 100'

Valve)

_____ St. and _____ St.

Distance from street main to stop cock box - 60' Ft.

Jerry H. Rudge

Supt. Water Dept.

City of Napoleon, Ohio
Water Department
New Service Connection

INSIDE

METER

Old

New

Service No. _____

Permit No. _____

Lot No. _____ of _____

_____ Addition

Date _____

Lot Owner HEARING Aid

Lot Fronts
_____ ft. on 525^E Riverview St.

and _____ ft. on _____ St.

Tapped 12 " TRAN main on North side of E Riverview St.,
between Filmore St. and Commerce Dr St.

No. of ferrules 1 / 1 Size of ferrules 2" across road / 1" off tee of 3

Connection - long or short _____

155' west hydrant 192)

Distance from _____ corner of) 155')
Valve)

_____ St. and _____ St.

Distance from street main to stop cock box - 60 Ft.

Jeffrey H. Partridge

Supt. Water Dept.

City of Napoleon, Ohio
Water Department
New Service Connection

INSIDE

METER

Old

New

Service No. _____

Permit No. _____

Lot No. _____ of _____

_____ Addition

Date _____

Lot Owner SUZY Q's

Lot Fronts
_____ ft. on 523^E Riverview St.

and _____ ft. on _____ St.

Tapped 12 " TRAN main on North side of E Riverview St.,
between Filmore St. and Commerce Dr St.

No. of ferrules 1 / 1 Size of ferrules 2" ACROSS ROAD / 1" off tee of 3

Connection - long or short long

154' west hydrant 192)

Distance from _____ corner of) 154')
Valve)

_____ St. and _____ St.

Distance from street main to stop cock box - 60 Ft.

Jeffrey H. Partridge

Supt. Water Dept.