

SEWER TAPPING PERMIT

Issued by

The City of Napoleon Engineering Dept.

255 West Riverview Ave. Napoleon, Ohio 43545 Ph. 592-4010

Entry No. \_\_\_\_\_

Permit No. S.A. 092-89 Issued 4-17-89 Build. Permit No. 01222

TAP FEE 275.00

Permit Fee \$ 60.00

Job Location 22 West

Street Bond \$ \_\_\_\_\_

Lot #2 Twin Oaks Sub'd.

Date Paid 4-17-89

sub div. or legal disc.

Issued By \_\_\_\_\_

Owner Lynn Kausch Ph. 599-9106

Address 718 Strong Napoleon

Agent C.F. Kausch Ph. 592-0921

Address 599 W. Maumee Napoleon

for office use only

WORK INFORMATION

Sanitary Sewer Tap  Size of Tap 4" Size and Type of Sewer P.V.C. Street to be Opened

yes no

Storm Sewer Tap  Size of Tap 4" Size and Type of Sewer P.V.C. Street to be Opened

yes no

Street opening Agreement Approval Date \_\_\_\_\_ Opening Bond Fee (Set by Engineer) \_\_\_\_\_

READ AND SIGN BELOW; The undersigned hereby agrees complete the work described above and to make use of said sewers only as allowed by and in strict accordance with all applicable provisions of The Napoleon Engineering Dept. Rules and Regulations, The Napoleon Standard Specification for Water Main, Sanitary Sewer and Storm Sewer Construction and other Pertinent Sections of the Napoleon Code of Ordinances.

Date 4/17/89 Signature of Applicant [Signature]

Permit not valid without signature

INSPECTION RECORD \_\_\_\_\_ to be completed by the Field Inspector

Date Inspection is made \_\_\_\_\_ Size and Type of Sewer 4" S.D.P. 75 ASTM 7079

Location SER PLAN Depth \_\_\_\_\_ Type of Test \_\_\_\_\_ Additional Information \_\_\_\_\_

Date \_\_\_\_\_ Inspected By FH + SONNY HELDERG signature of inspector

Sketch Of Installation on Back or Attached

1340  
W. RIVERBANK

1320  
W. RIVERBANK

35.17'

CAP FOR  
FUTURE USE  
4" S.P.R.  
35



45° ELBOW

52'

26'

BUILDING

4" S.D.R. 35  
P.S. TAX 3034

4" S.P.R. 35



EXISTING  
TAP DEEP 8'-6"

P.P.W.



83'-0"  
TO DOWNSTREAM MANHOLE

PROPERTY  
LINE

150.17'

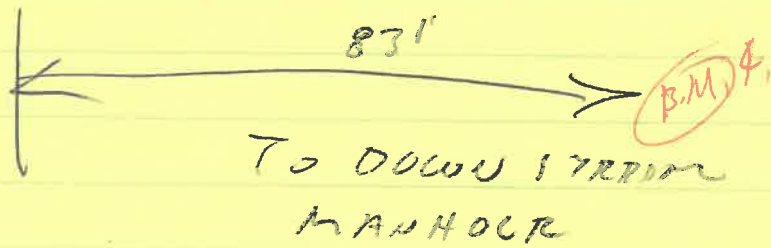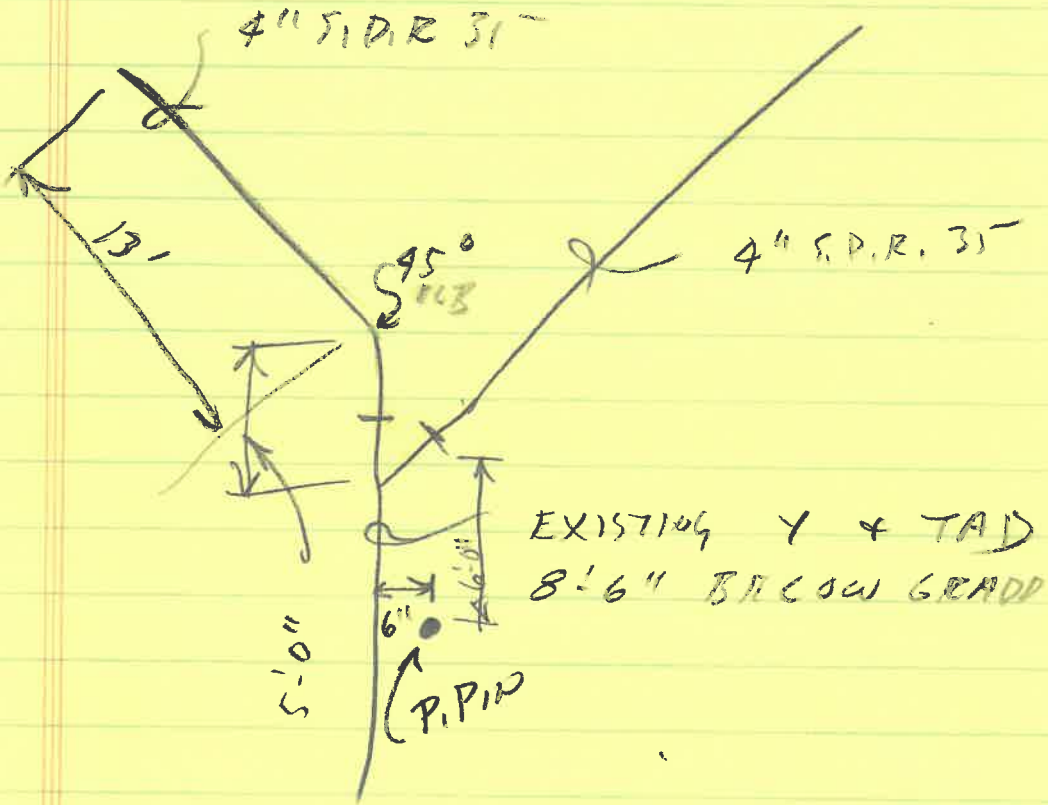

dynn Rausch

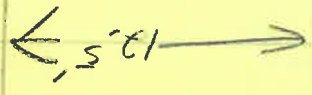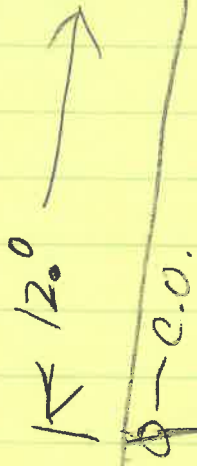

13

26

27

13