

SCANNED

THE CITY OF NAPOLEON

BUILDING & ZONING DEPARTMENT

255 W. RIVERVIEW

(419)592-4010

Outside Sewer Permit

Permit Number: OS2010-27

Page 1 of 2

Printed: 8/31/2010

ADDRESS:

406 Riverview Ave. W.

Applicant

Name: JA Hillis LLC

Address: 13645 County Road M

Approval Date: 8/31/2010

419-591-1410

Owners

Name: Mr. Lester Brubaker

Address: 406 W. Riverview Ave.

Napoleon, OH 43545

Phone: 419-592-6641

Contractors

Contractor Type: Builder

Name: JA Hillis LLC

Address: 13645 County Road M

Napoleon, OH 43545

Phone: 419-591-1410

Contractors

Contractor Type: Other

Name: Moore's Plumbing

Address: O-829 Co Rd 11C

Napoleon, OH 43545

Phone: 419-599-1993

Fees and Receipts:

Number

Description


Amount

Total Fees: **\$0.00**

Total Receipts: **\$0.00**

Install Cleanout on sanitary sewer

APPLICANTS SIGNATURE:

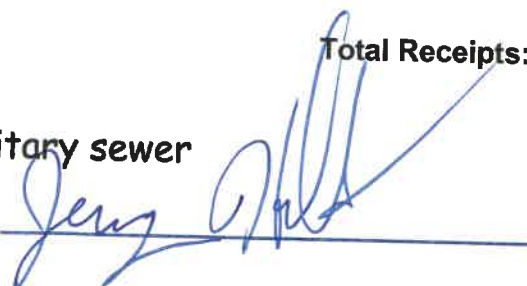

DATE:

8-31-10

DATE: 8-31-10
INSTALLED BY: KIM MOORE / JA HILLIS
INSPECTED BY: MARTY CROSSLAND
1" = 20'

SCANNED

415


03123

406

WEST RIVERVIEW AVE.

408

4" clo 3' DEEP FIL
BRICK SEPTIC TANK
FILLED IN W #8
STONE

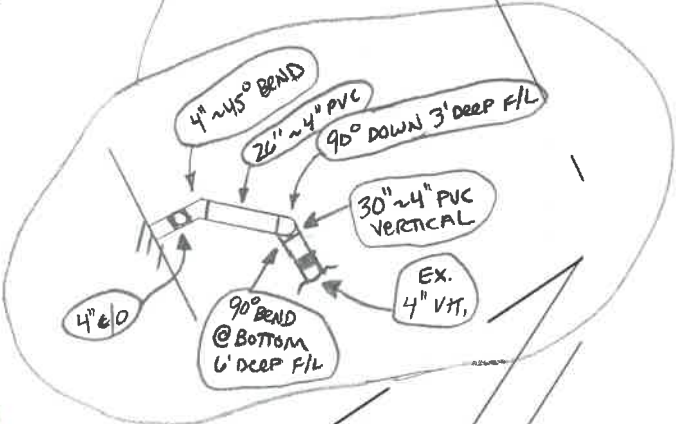

8" San.

15" St

