

SEWER TAPPING PERMIT

Issued by

The City of Napoleon Engineering Dept.

255 West Riverview Ave. Napoleon, Ohio 43545 Pn. 592-4010

Entry No. _____

Permit No. SA 0100-89 Issued 5-5-89 Build. Permit No. 01673

Permit Fee \$ 60.00

Job Location 826 Riverview

Street Bond \$ _____

Lot 189 ADAM STOUTS 1ST ADD sub div. or legal disc.

Date Paid _____

Issued By E

Owner T Gigger Pn. 592 1420

Address 826 Riverview

Agent Beck's Const Pn. 592 8307

Address 11622 Rd M Nap O

for office use only

WORK INFORMATION

Sanitary Sewer Tap yes Size of Tap 4 Size and Type of Sewer 4 plastic Street to be Opened X

Storm Sewer Tap yes Size of Tap 4 Size and Type of Sewer ADS Street to be Opened X

Street opening Agreement Approval Date _____ Opening Bond Fee (Set by Engineer) _____

READ AND SIGN BELOW; The undersigned hereby agrees complete the work described above and to make use of said sewers only as allowed by and in strict accordance with all applicable provisions of The Napoleon Engineering Dept. Rules and Regulations, The Napoleon Standard Specification for Water Main, Sanitary Sewer and Storm Sewer Construction and other Pertinent Sections of the Napoleon Code of Ordinances.

Date 4/5/89 Signature of Applicant Robert L Beck Permit not valid without signature



INSPECTION RECORD _____ to be completed by the Field Inspector

Date Inspection is made _____ Size and Type of Sewer _____

Location _____ Depth _____ Type of Test _____ Additional Information _____

Date _____ Inspected By _____ signature of inspector

Sketch Of Installation on Back or Attached

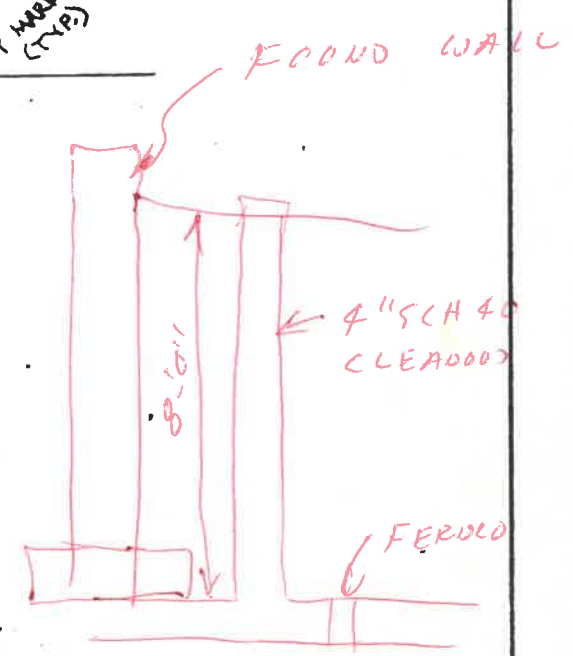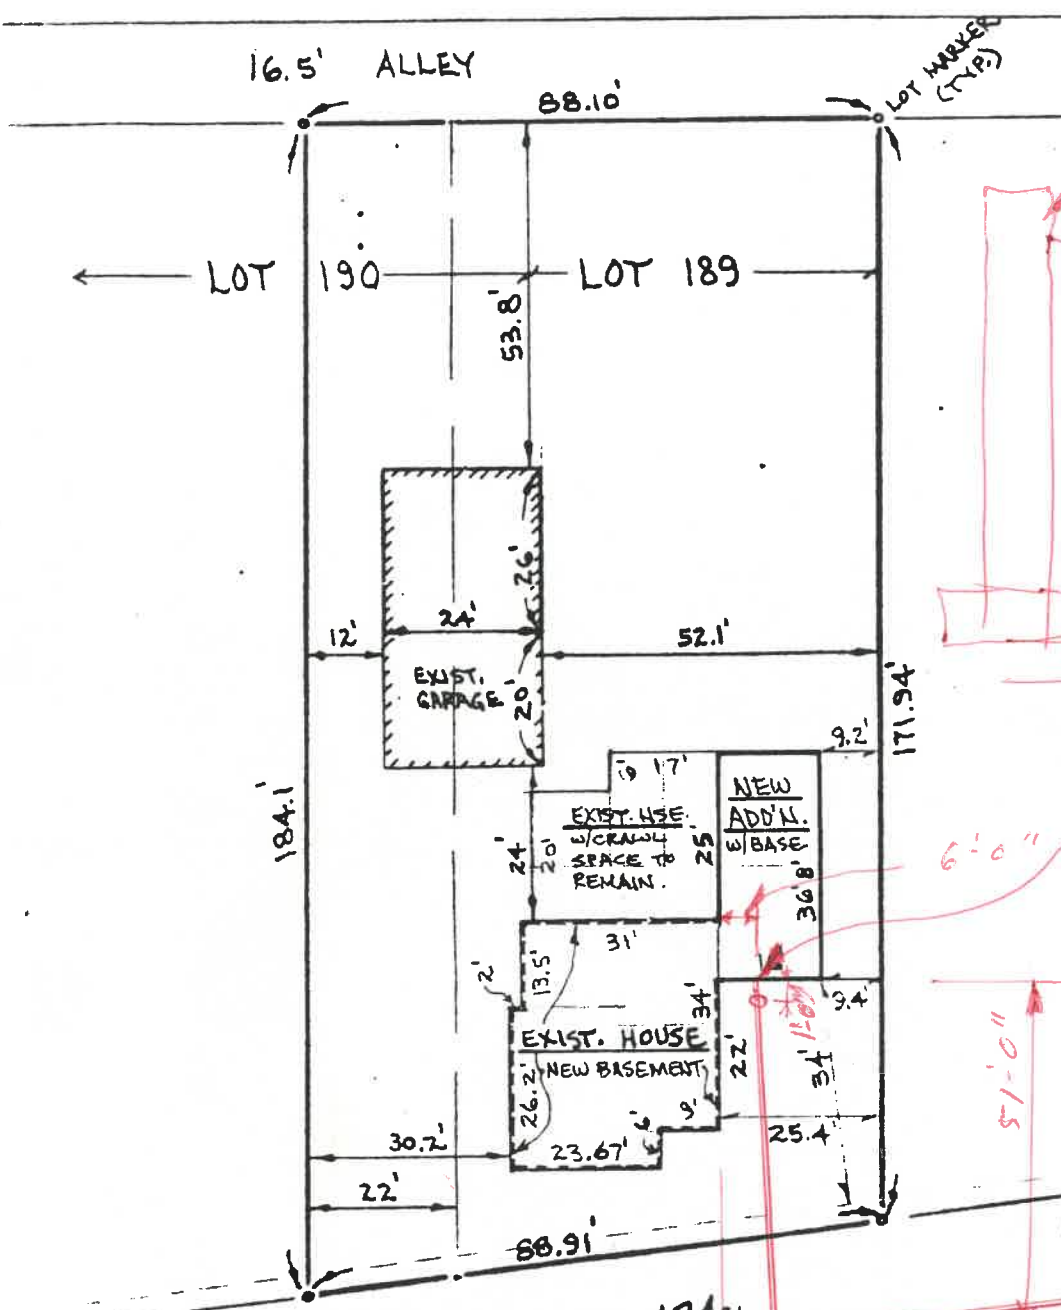

6'-0" FERROD FROM 4" SCH 40 TO S.I.D.R. 35

W. RIVERVIEW AVENUE - S.R. 424

EXISTING SEWER MAIN VITI

SITE PLAN
 1" = 30'

10'-0"

SADDLE TEE 12'-6" BELOW PAVEMENT TO TOP OF SEWER MAIN

BECK CONSTRUCTION CO.

FOR: TREVA GEIGER
 826 W. RIVERVIEW AVE.
 NAPOLEON, OHIO 43545