

APPLICATION FOR PERMIT TO TAP SEWER

Owner  Elsie Yoram  
ADDRESS  231 E Main  
CONTRACTOR  Bell Plumbing & Heating  
ADDRESS 1201 Woodlawn TEL. 599-1786

NO. SA 0053-88  
BLDG. PERMIT NONE  
PERMIT FEE \$ 60.00  
STREET BOND NONE  
DATE PAID 5-13-88  
For office use only

LOCATION OF CONNECTION

Street and No. 1220 SCOTT ST. Sanitary  Storm \_\_\_\_\_  
Lot No. NW 1/4 NW 1/4 Subdivision SECTION 14 NAP TOWNSHIP Size of Tap \_\_\_\_\_  
Size and Type of Sewer  S.P.R. 35" ALL WORK MUST BE INSPECTED  
Street to be opened-Yes \_\_\_\_\_ No  Opening bond fee set by Engineer \$ N/A  
Street opening agreement approval date NONE

I certify that the sewer will be used only as indicated and no other drainage will be connected.

Date  5-13-88 Signature  William Elmy  
Owner-Builder-Agent

DO NOT WRITE BELOW THIS LINE

INSPECTION RECORD

Date Inspected  6-15-88 Size and Type of Sewer 4" P.O.C.  
Location SEE SITE PLAN Depth SEE SITE P. Type of Test NONE  
Inspected and Approved by:  Malcolm Nelberg  7-7-88  
Inspector Date


Additional information \_\_\_\_\_

Send copy to: \_\_\_\_\_

SKETCH OF INSTALLATION - ON BACK

PAID  
MAY 13 1988

CITY OF NAPOLEON

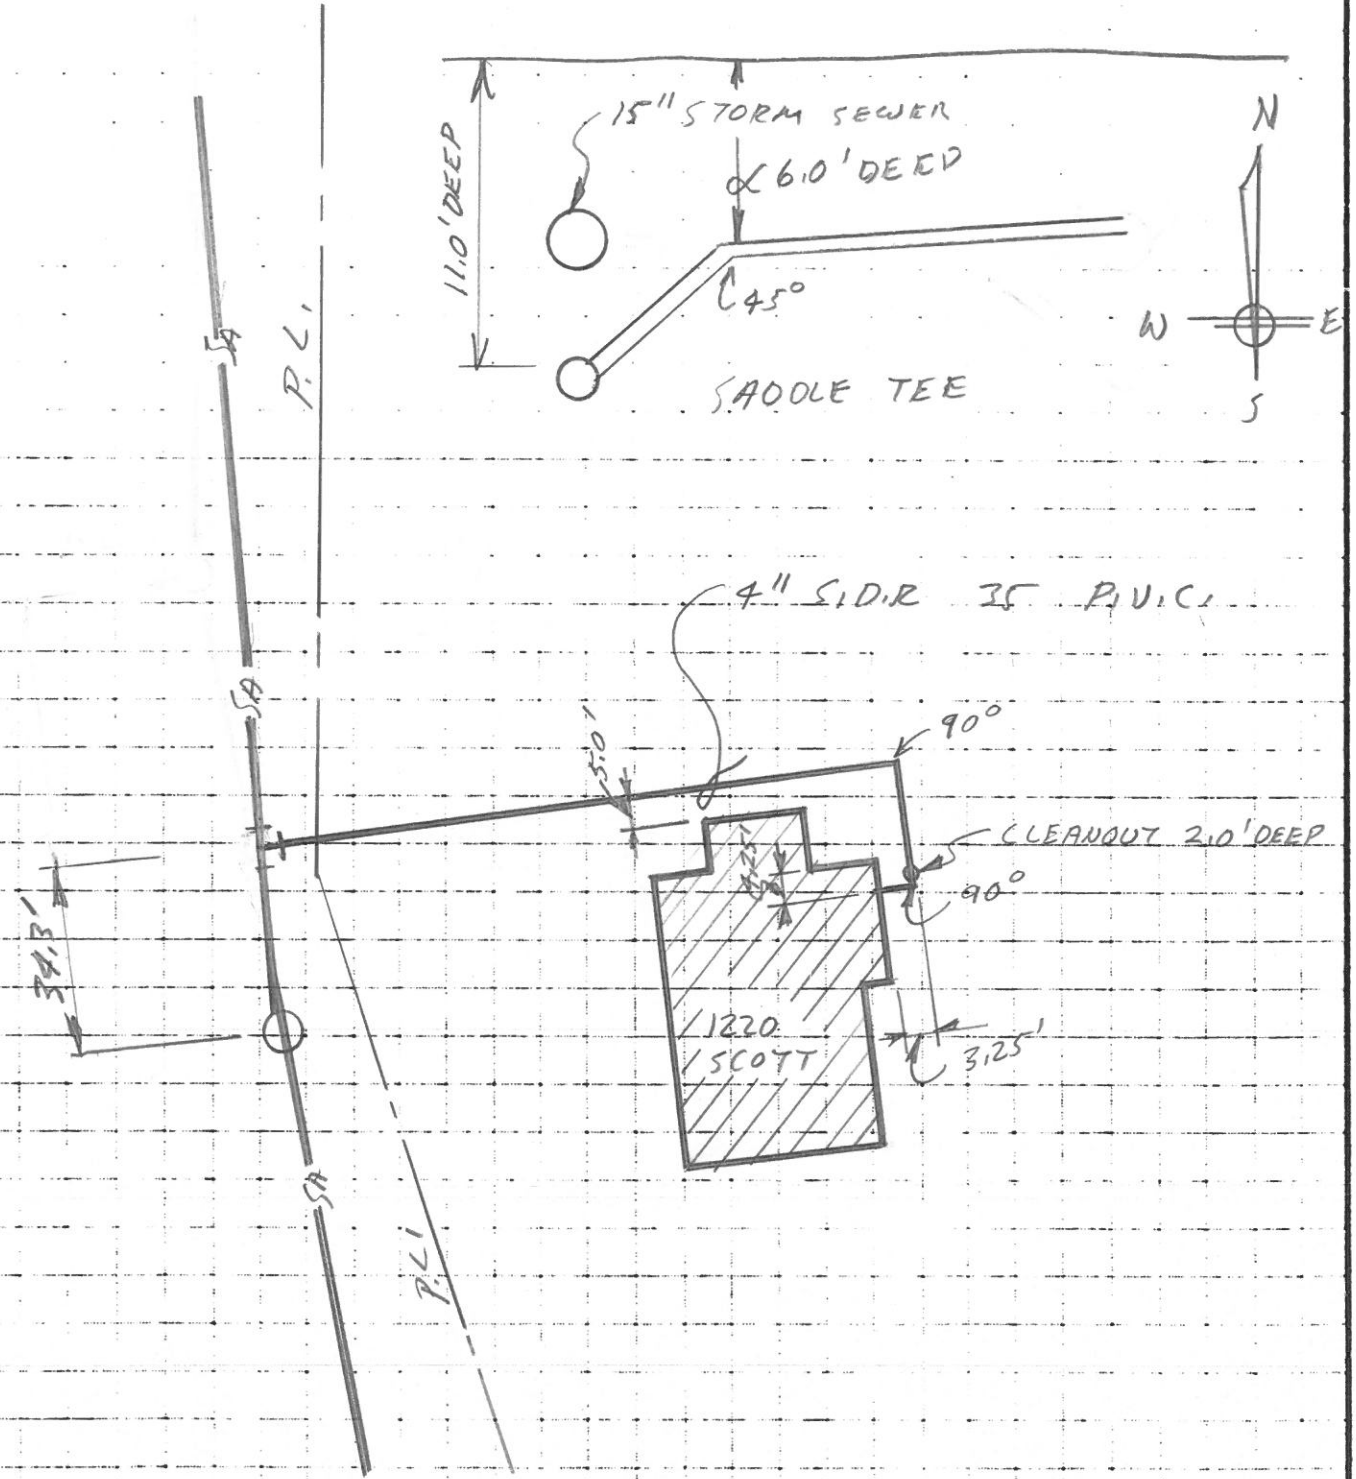


Elsie Young

12203 Scott St.



Scott

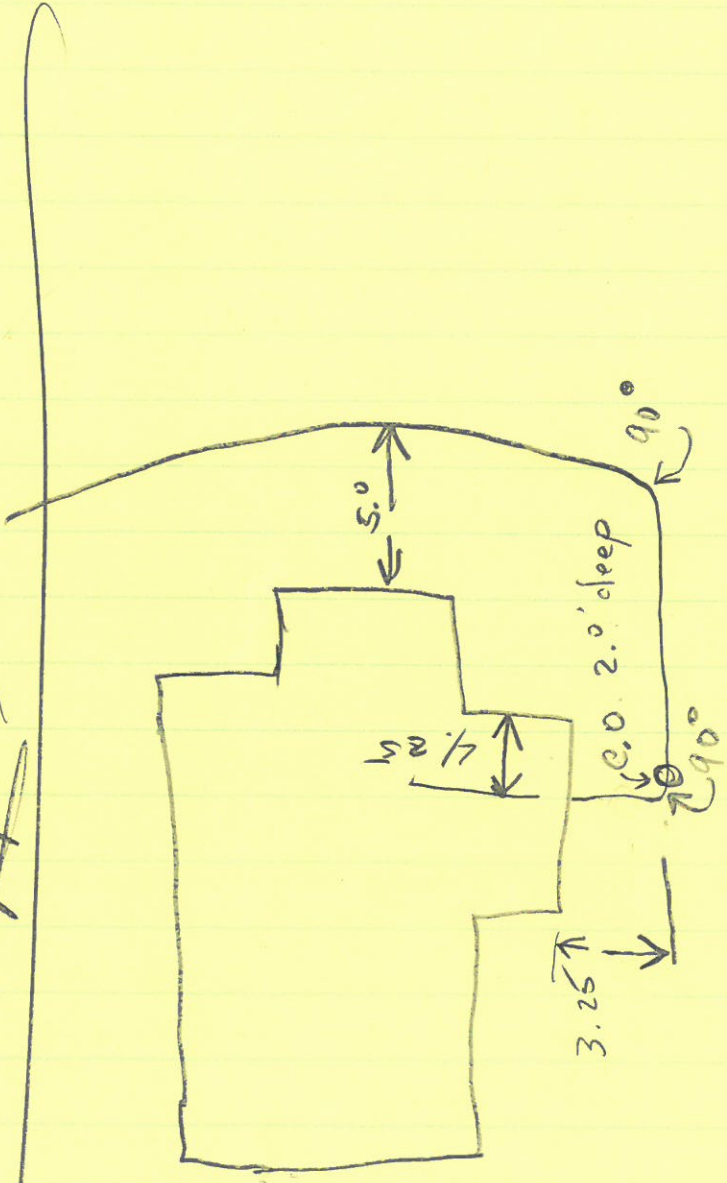

34.30 To Downstream m.H.  
11.00 deep @ Main

15" Storm Sewer Above

