




toledo sign company

26 SOUTH HURON STREET
TOLEDO, OHIO 43602
PHONE (419) 244-4444
FAX (419) 244-6546

ALL SIGN DESIGNS AND CONCEPTS SHOWN
HERE ARE CONFIDENTIAL AND THE PROPERTY
OF TOLEDO SIGN COMPANY. NO USE OR
DISCLOSURE THEREOF MAY BE MADE
WITHOUT OUR WRITTEN PERMISSION.

DATE OF DRAWING	8/19/11	DWG NO	3344
REVISED DATE	10/11/11	BY	BJH
APPROVED SIGNATURE			
CUSTOMER	NAPOLEON, OHIO		
ADDRESS			
PHONE			
SCALE	1/4" = 1'-0"		

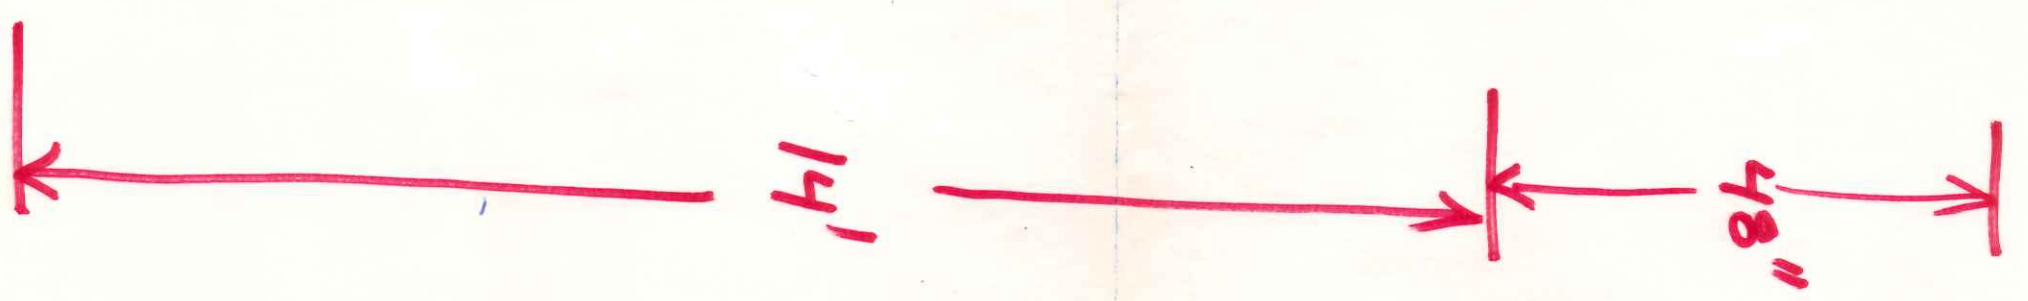

the
PHARM
 DEEP DISCOUNT
DRUGS

~~PHARMACY~~
~~VIDEO~~

~~DISCERNIBLE~~

5' x 19'
 FLEX-FACE SIGN
 ON EXISTING POLE

#80

NAPOLEON, OHIO

1304
 Scott St



toledo sign company

25 SOUTH HURON STREET
TOLEDO, OHIO 43602
PHONE (419) 244-4444
FAX (419) 244-6546

ALL SIGN DESIGNS AND CONCEPTS SHOWN
HERE ARE CONFIDENTIAL AND THE PROPERTY
OF TOLEDO SIGN COMPANY. NO USE OR
DISCLOSURE THEREOF MAY BE MADE
WITHOUT OUR WRITTEN PERMISSION.

DATE OF
DRAWING
REVISED
DATE

8 1 9 1 9 1
3 3 4 4

CUSTOMER



ADDRESS

PHONE

SCALE 1/2" = 1'-0"

BY



MAE

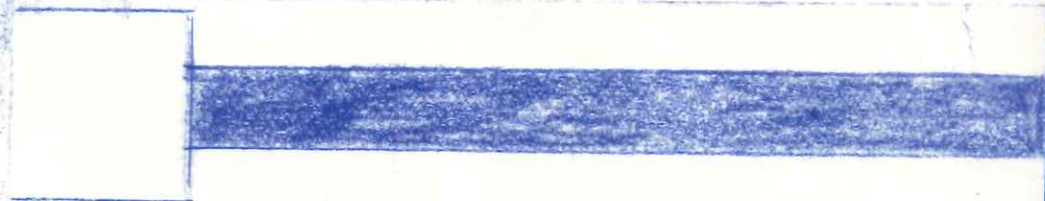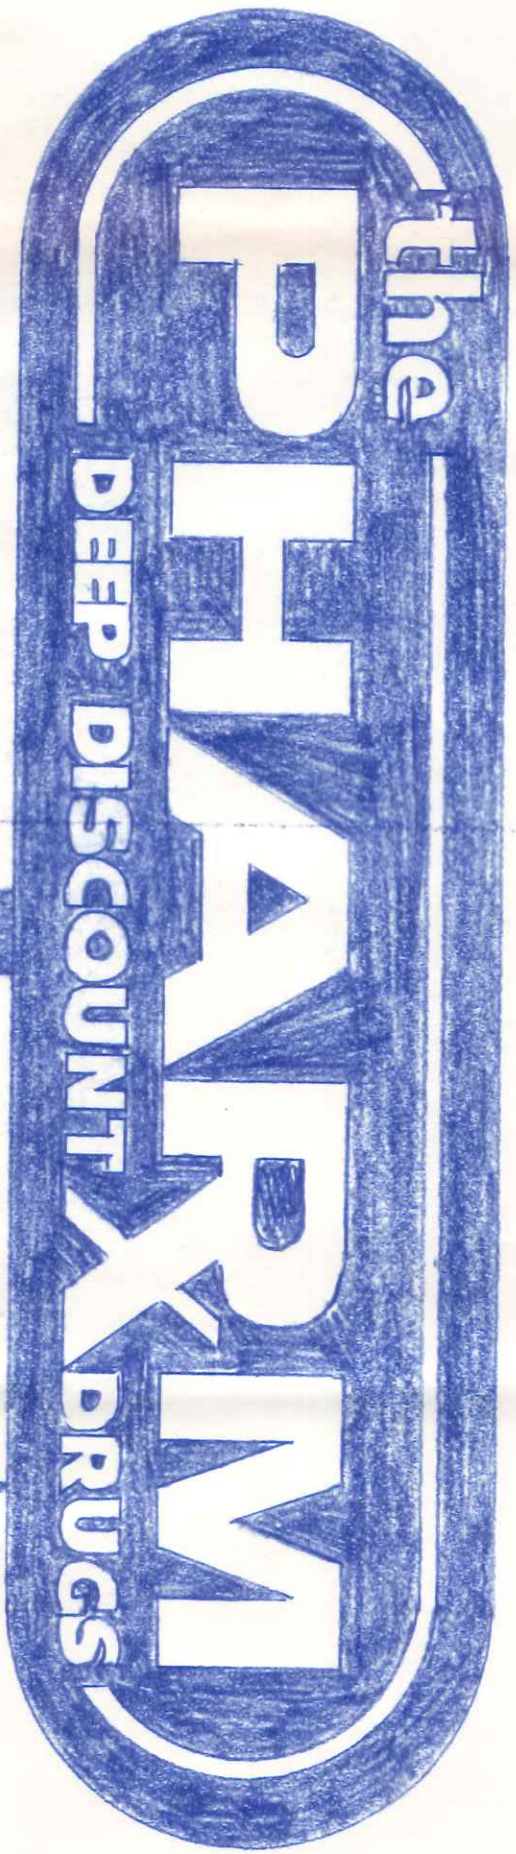

NAPOLÉON, OHIO

5' x 19'
FLEX-FACE SIGN
ON EXISTING POLE

4' x 10' PLASTIC
ILLUMINATED SIGN

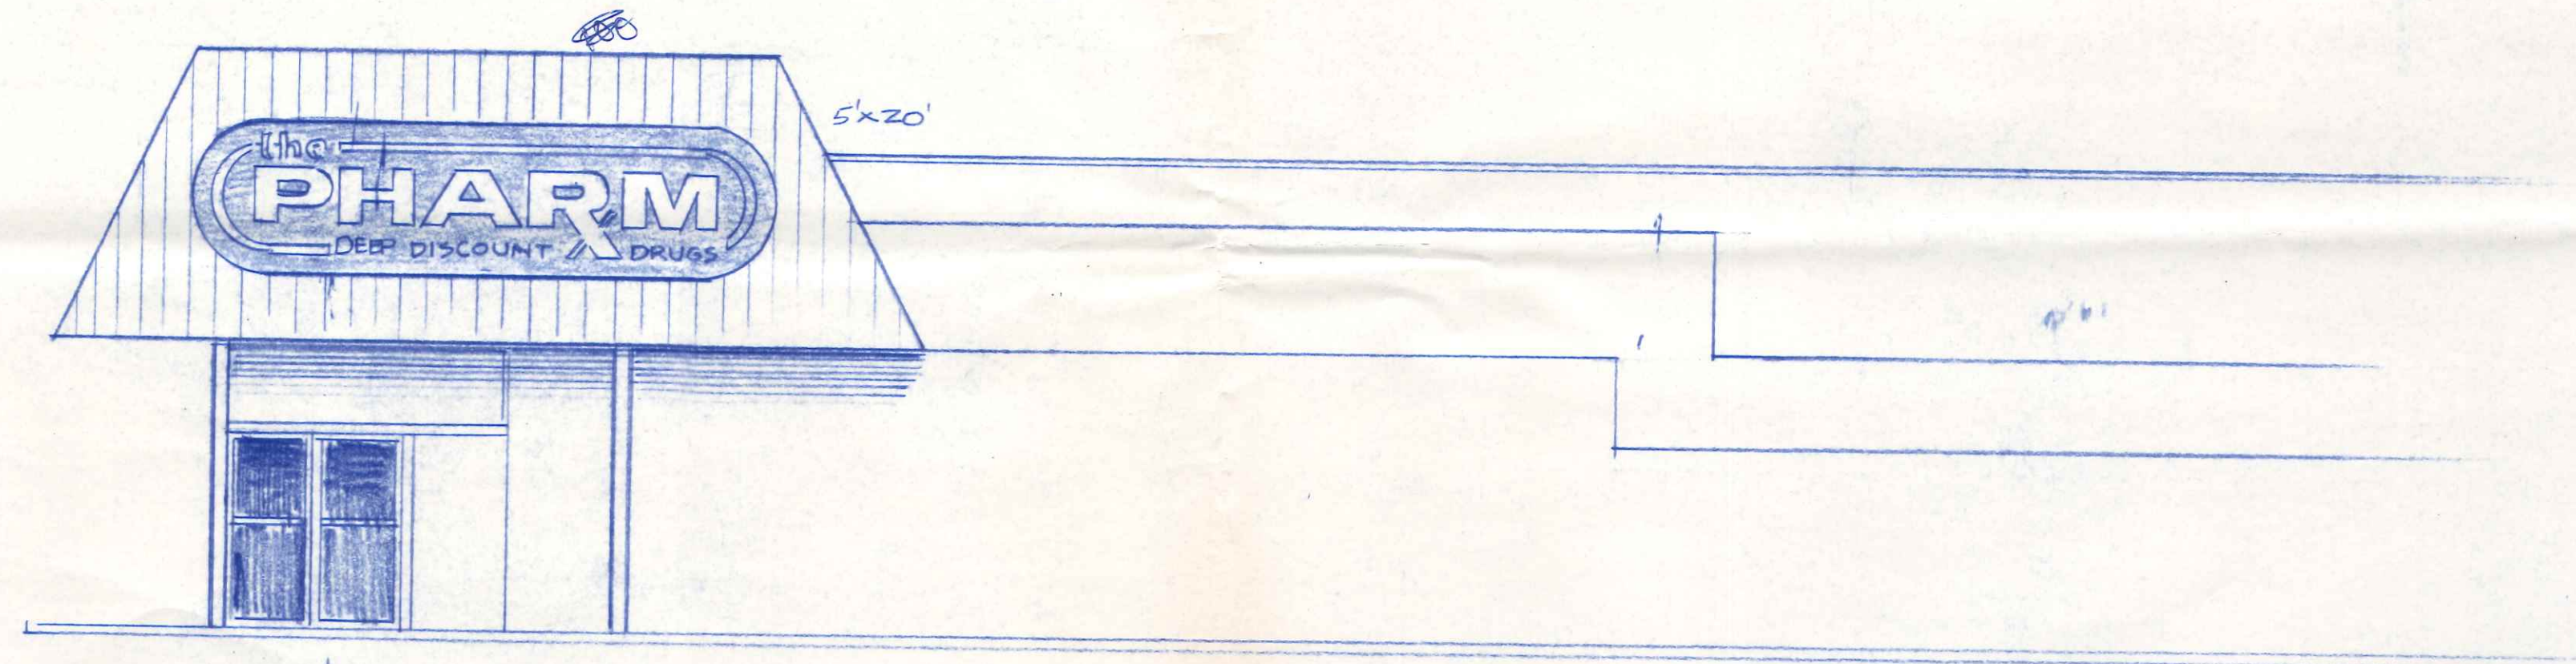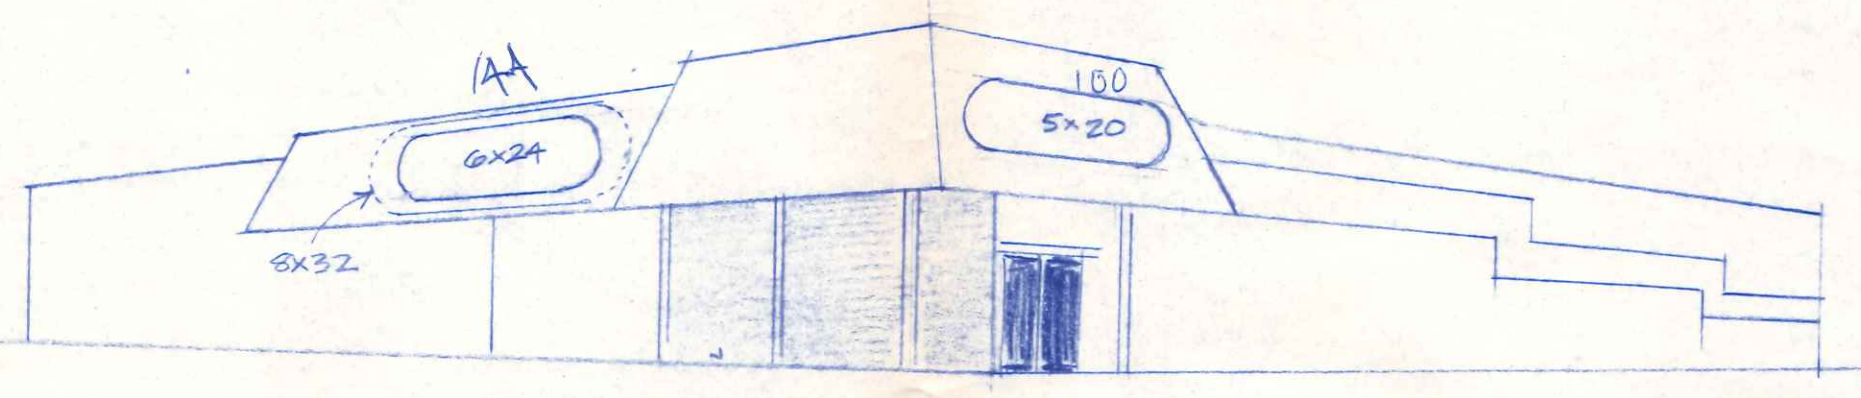

NAPOLEON, OHIO




toledo sign company

25 SOUTH HURON STREET
 TOLEDO, OHIO 43602
 PHONE (419) 244-4444
 FAX (419) 244-6546

ALL SIGN DESIGNS AND CONCEPTS SHOWN
 HERE ARE CONFIDENTIAL AND THE PROPERTY
 OF TOLEDO SIGN COMPANY. NO USE OR
 DISCLOSURE THEREOF MAY BE MADE
 WITHOUT OUR WRITTEN PERMISSION.

DATE OF DRAWING 8/8 191
 REVISED DATE
 DWG. NO. 3340
 APPROVED SIGNATURE

CUSTOMER
 ADDRESS
 PHONE
 SCALE 3/16" = 1'-0"
 DRAWN BY TAE

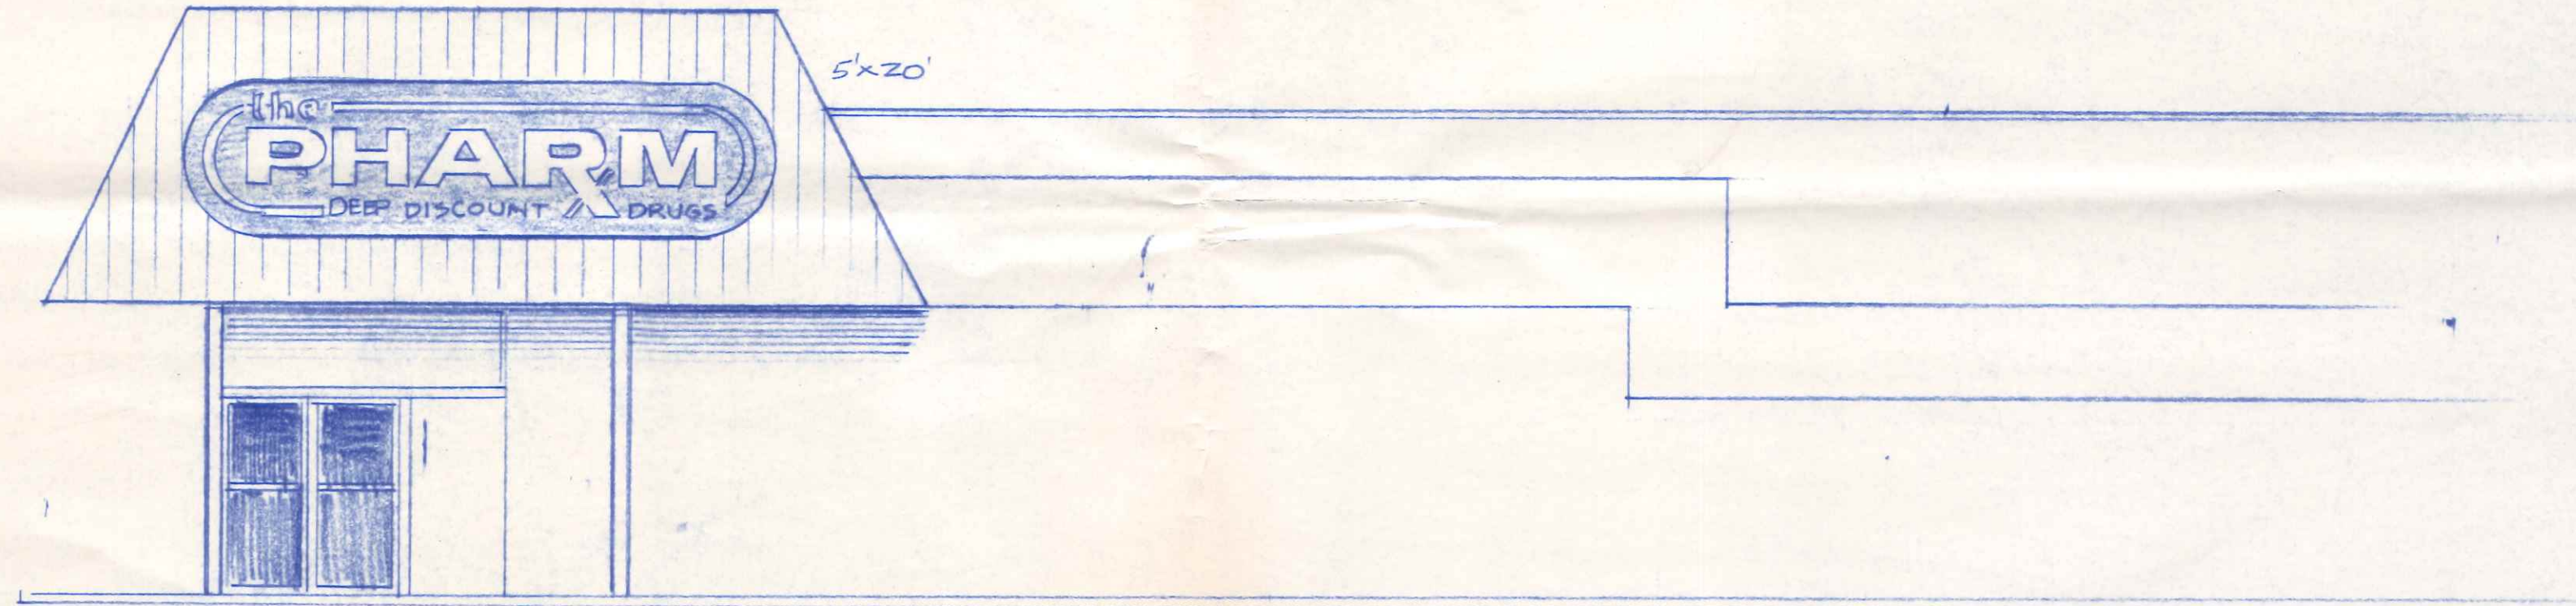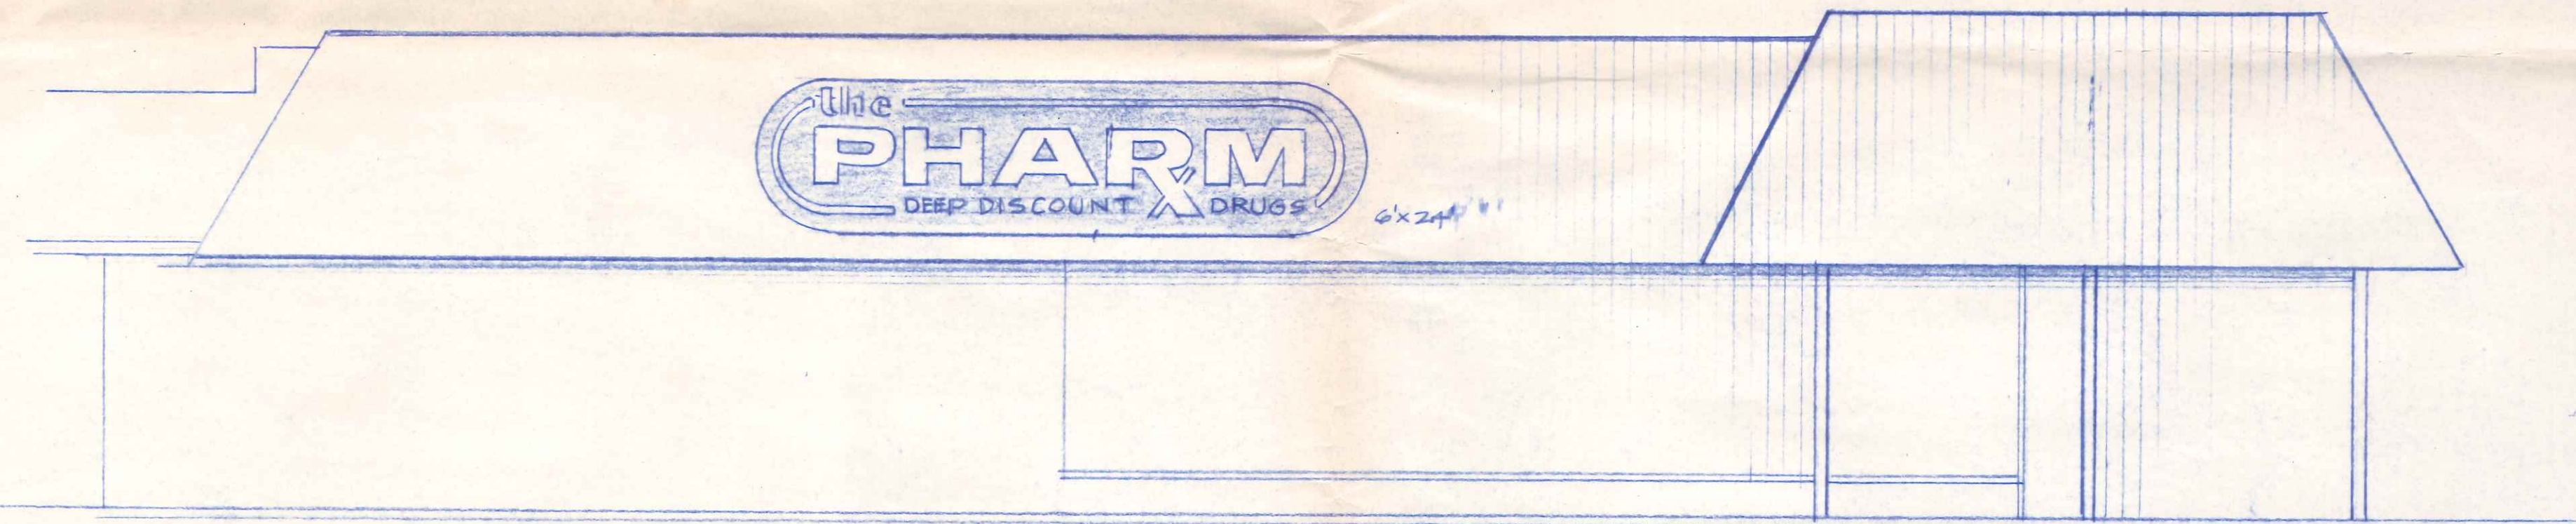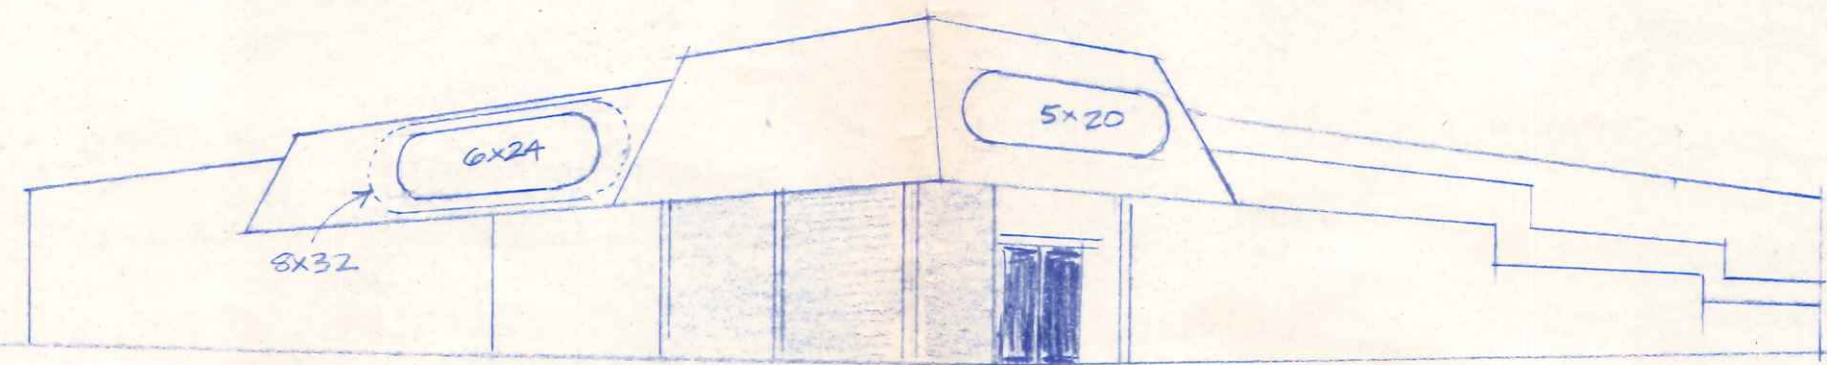

NAPOLEON, OHIO

toledo sign company

25 SOUTH HURON STREET
 TOLEDO, OHIO 43602
 PHONE (419) 244-4444
 FAX (419) 244-6546

ALL SIGN DESIGNS AND CONCEPTS SHOWN
 HERE ARE CONFIDENTIAL AND THE PROPERTY
 OF TOLEDO SIGN COMPANY. NO USE OR
 DISCLOSURE THEREOF MAY BE MADE
 WITHOUT OUR WRITTEN PERMISSION.

DATE OF DRAWING 8/8/91	DWG NO. 3340	CUSTOMER
REVISED DATE		ADDRESS
APPROVED SIGNATURE		PHONE
		SCALE 3/16" = 1'-0"
		DRAWN BY J.A.E.