

SEWER TAPPING PERMIT

Issued by

The City of Napoleon Engineering Dept.

255 West Riverview Ave. Napoleon, Ohio 43545 Pn. 592-4010

Entry No. _____

Permit No. ⁰¹¹⁵ ~~S.A. 2115~~-89 Issued 10-4-89 Build. Permit No. _____

Permit Fee \$ 100.⁰⁰

Job Location 1412 1/2 North Scott Street

Street Bond \$ NO UR REQ.

Lot 1 Henry Landmark Inc. 1st Addition
sub div. or legal disc.

Date Paid 10-4-89

Issued By FH

Owner V IDEO CONNECTION Pn. _____

Address _____

Agent RUPP ROSEBROCK Pn. 893-7999

for office use only

Address 1684 WOODLANDS DR MAUMEE OH
43537

WORK INFORMATION

Sanitary Sewer Tap Size of Tap 6 Size and Type of Sewer S.D.R. ST Street to be Opened
yes no AS7M 3034 yes no

Storm Sewer Tap Size of Tap 6" Size and Type of Sewer P.V.C. Street to be Opened
yes no yes no

Street opening Agreement Approval Date NO UR Opening Bond Fee (Set by Engineer) _____

READ AND SIGN BELOW; The undersigned hereby agrees complete the work described above and to make use of said sewers only as allowed by and in strict accordance with all applicable provisions of The Napoleon Engineering Dept. Rules and Regulations, The Napoleon Standard Specification for Water Main, Sanitary Sewer and Storm Sewer Construction and other Pertinent Sections of the Napoleon Code of Ordinances.

Date Oct 4, 89 Signature of Applicant Malcolm Helberg

Permit not valid without signature

INSPECTION RECORD _____ to be completed by the Field Inspector


Date Inspection is made 10-7-89 Size and Type of Sewer 6" P.V.C.

Location SEE PLAN Depth SEE PLAN Type of Test _____ Additional Information _____

Date 11-28-89 Inspected By Malcolm Helberg

signature of inspector

Sketch Of Installation on Back or Attached

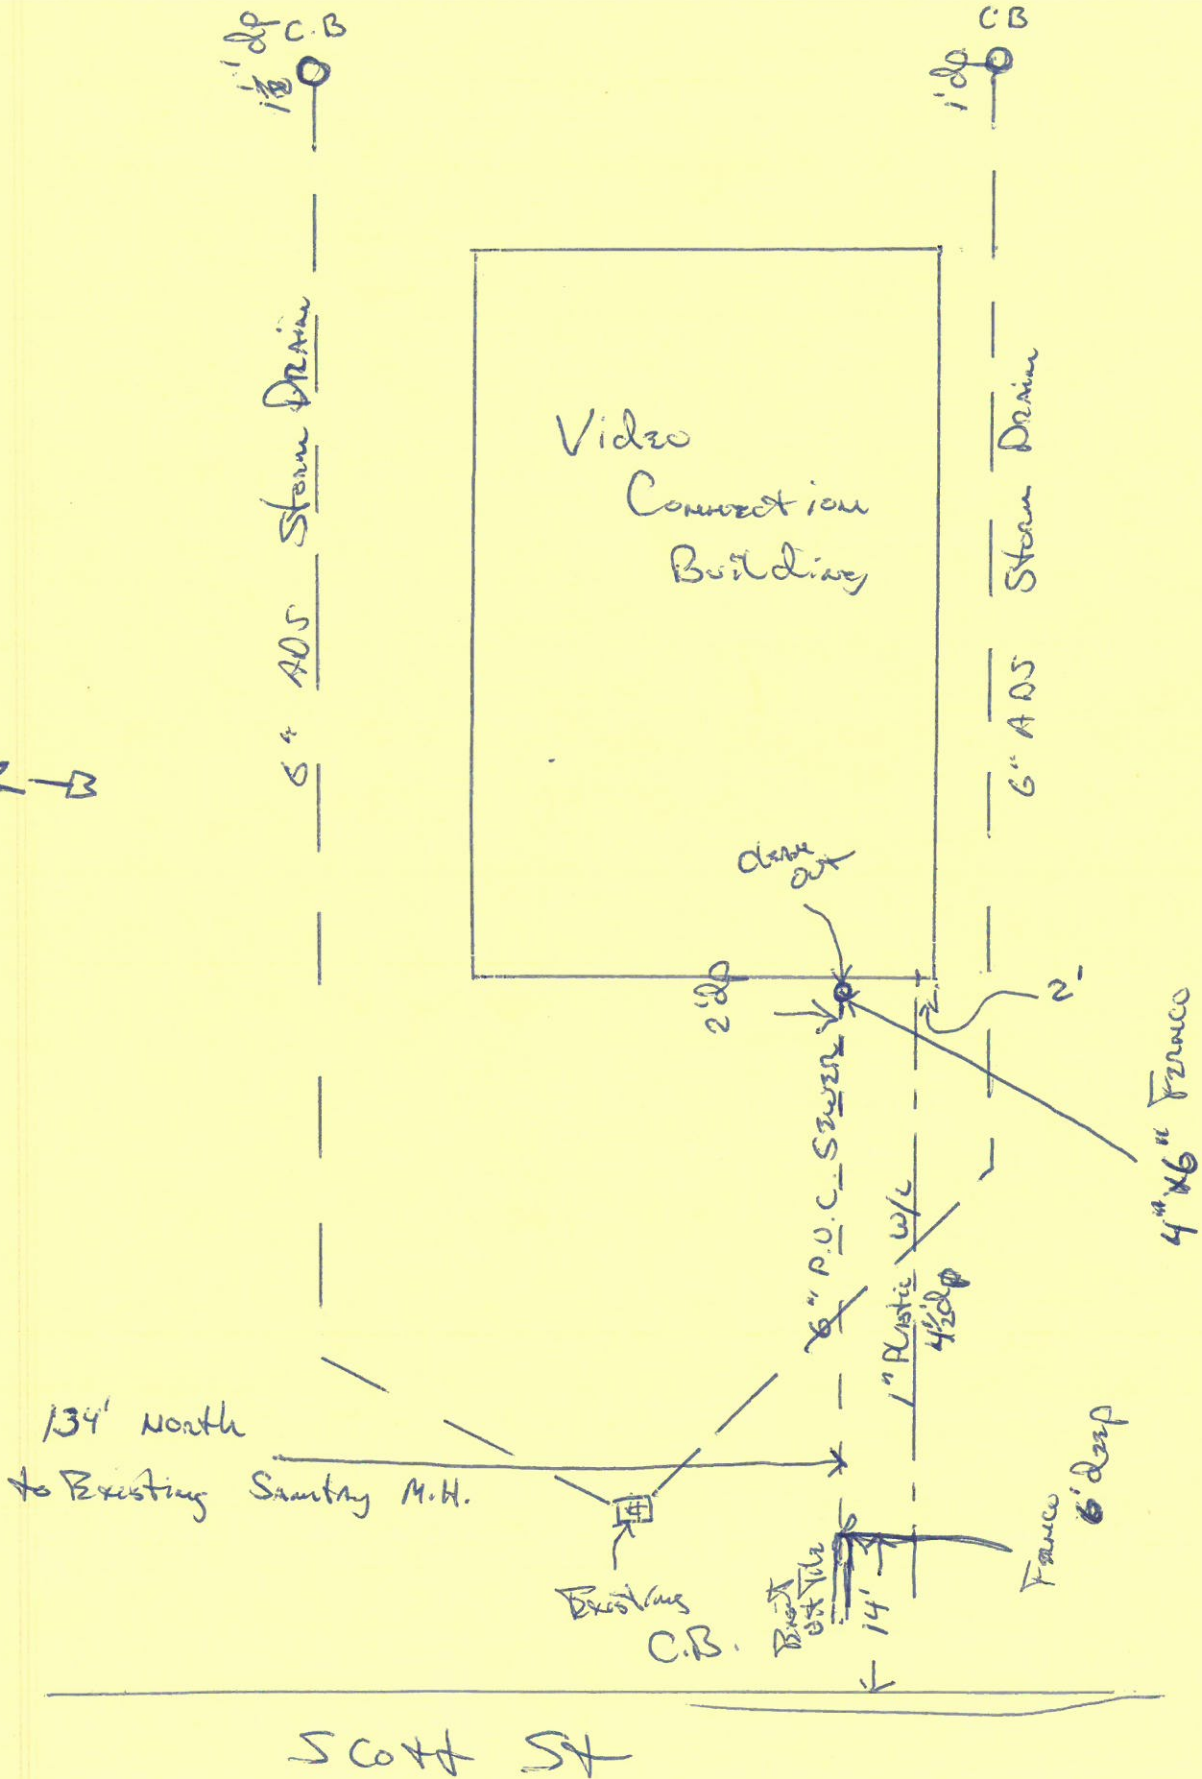

10/25/89

Video Conn.

6" SEWER INSTALLED

222
1841
2073

