

APPLICATION FOR PERMIT TO TAP SEWER

(Print or Type)

Owner LAND MARK INC. NO. 5-81-1
Address SCOTT ST. BLDG. PERMIT U/A
Contractor J. A. SCHULTZ & SON INC. PERMIT FEE \$ 1200
Address TAP. O. Tel. 592-3946 DATE PAID 3-5-81

for office use only

LOCATION OF CONNECTION

Street and No. 1414 SCOTT ST. Sanitary Storm
Lot No. _____ Subdivision _____ Size of Tap 6"
Size and Type of Sewer 6" P.V.C. ALL WORK MUST BE INSPECTED

I certify that the sewer will be used only as indicated and no other Drainage will be connected.

Date 3-4-81 Signature J. A. Schultz & Son Inc.
owner-builder-agent
do not write below this line

INSPECTION RECORD

Date Inspected 3-5-81 Size and Type of Sewer 6" PVC


Location SIDE Depth See Dewy Type of Test N/A

Inspected and Approved By: Bruce W. Morgan 3-5-81
Inspector Date

Additional Information TAP PROVIDED LAY NEXT TO POWER POLE @ DRIVE THEREFORE CONTRACTOR WAS PERMITTED TO BREAK INTO MAIN AND SADDLE TAP.

Send copy to: _____

SKETCH OF INSTALLATION

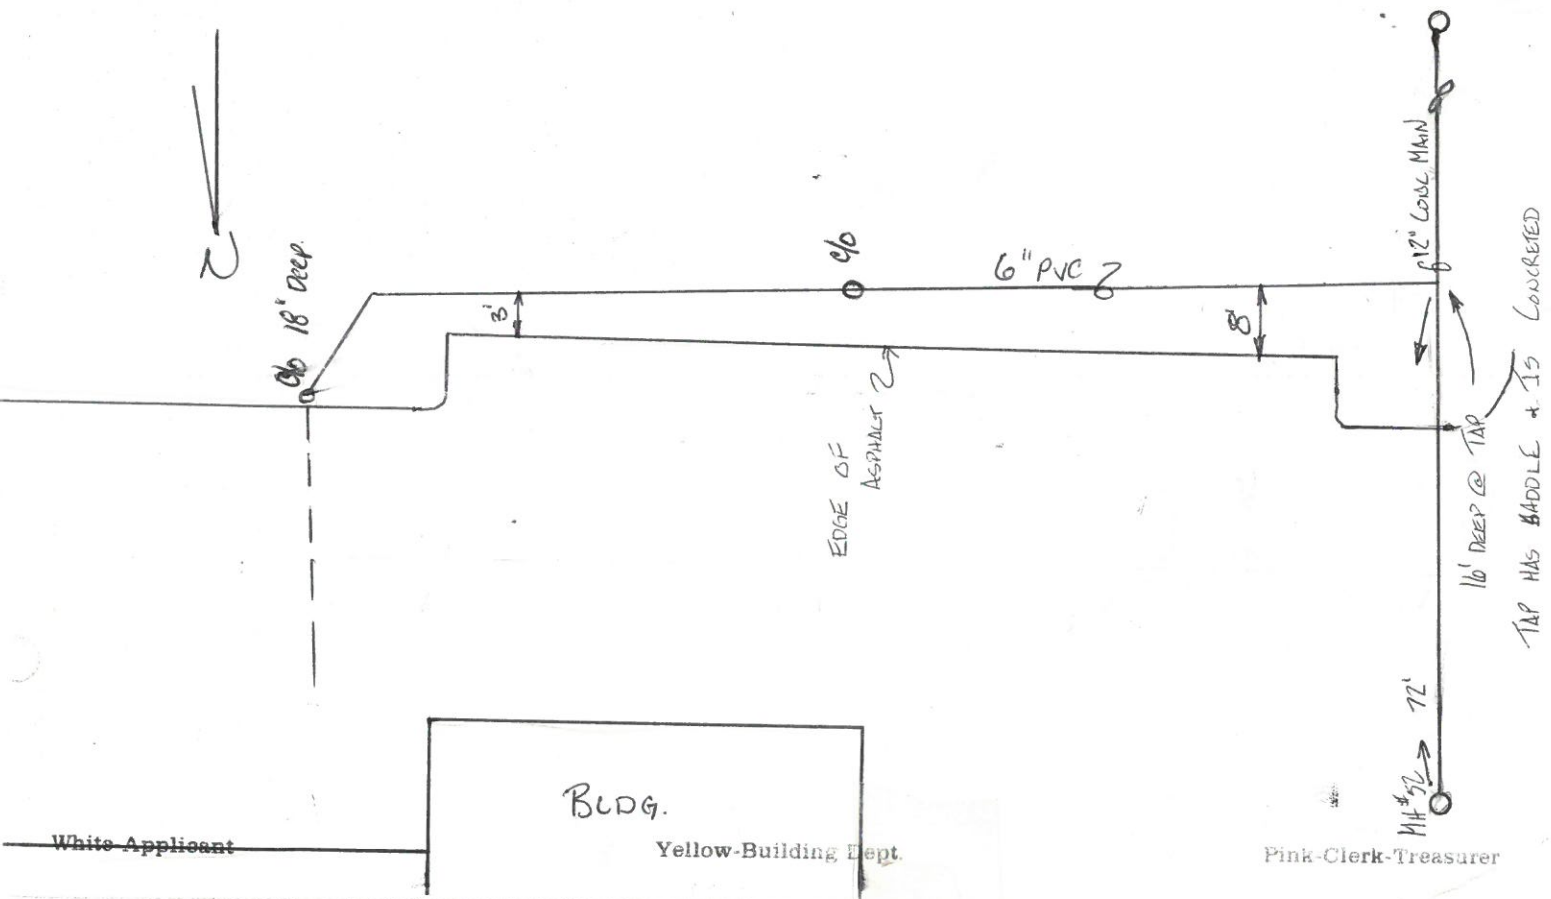

White - Applicant

Yellow - Building Dept.

Pink - Clerk-Treasurer