

SEWER TAPPING PERMIT

Issued by

The City of Napoleon Engineering Dept.

255 West Riverview Ave. Napoleon, Ohio 43545 Pn. 592-4010

Entry No. _____

Permit No. ~~SA 0109~~ ⁰¹¹⁹ Issued 11-9-89 Build. Permit No. None

. Permit Fee \$ 120.⁰⁰

Job Location 1414 Scott Str.

. Street Bond \$ _____

Lot 2 LANDMARK ADDITION
sub div. or legal disc.

. Date Paid _____

Issued By FH

Owner Kenny Woods Pn. _____

Address 907 OAKWOOD

Agent Meyers Plumbing & Heating Pn. 592-6771

Address 829 N. Perry St

. for office use only
.....

WORK INFORMATION

Sanitary Sewer Tap Size of Tap 6" Size and Type of Sewer 6" P.V.C. Street to be Opened
yes no yes no

Storm Sewer Tap _____ Size of Tap _____ Size and Type of Sewer _____ Street to be Opened _____
yes no yes no

Street opening Agreement Approval Date _____ Opening Bond Fee (Set by Engineer) _____

READ AND SIGN BELOW; The undersigned hereby agrees complete the work described above and to make use of said sewers only as allowed by and in strict accordance with all applicable provisions of The Napoleon Engineering Dept. Rules and Regulations, The Napoleon Standard Specification for Water Main, Sanitary Sewer and Storm Sewer Construction and other Pertinent Sections of the Napoleon Code of Ordinances.

Date _____ Signature of Applicant [Signature]

Permit not valid without signature



INSPECTION RECORD _____ to be completed by the Field Inspector

Date Inspection is made _____ Size and Type of Sewer _____

Location _____ Depth _____ Type of Test _____ Additional Information _____

Date _____ Inspected By _____
signature of inspector

Sketch Of Installation on Back or Attached

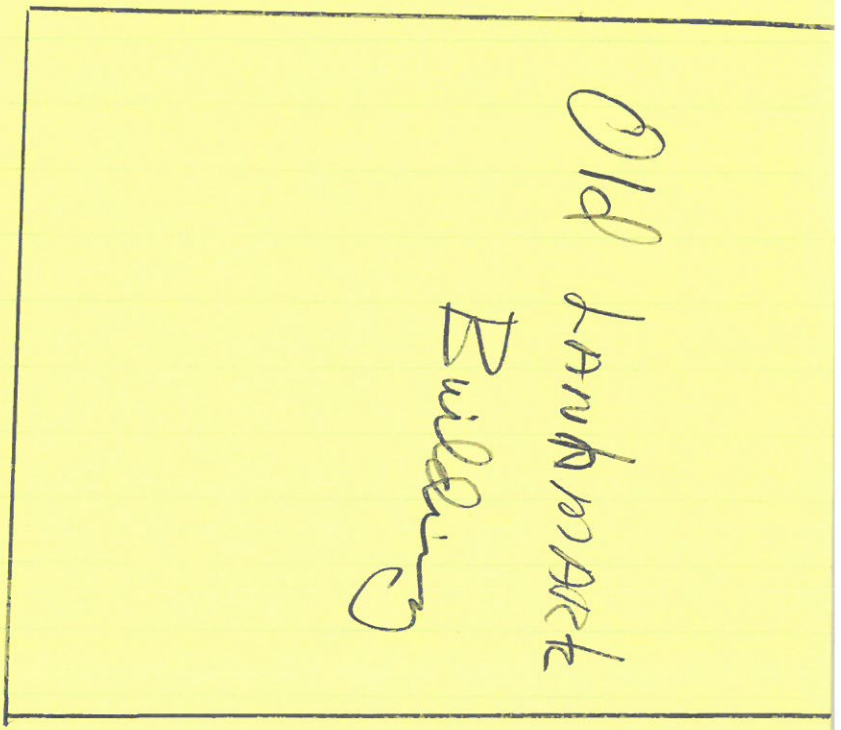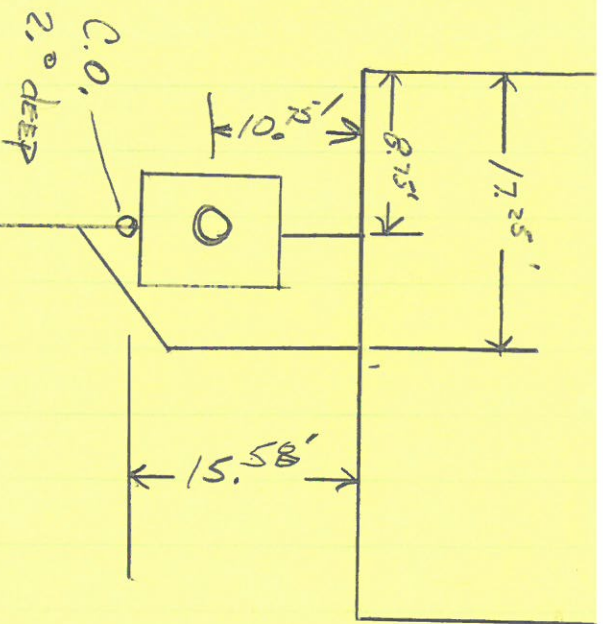

137' To Down Street N. 11.

