

PERMIT

CITY OF NAPOLEON - BUILDING DEPARTMENT

255 West Riverview Avenue, Napoleon, Ohio 43545 - 419-592-4010

Permit No. 01839 Issued 9-22-89
date

Job Location 1024 Sheffield
address

Lot 61 Highlands 2nd Addition
sub-div or legal discript

Issued By Eldon Huber
building official

Owner Tom Rosak
name tel.

Address P.O. Box 688

Agent C.F. Plumbing & Heating
builder-eng.-etc. tel.

Address 403 E. Washington

Description of Use _____

Residential _____
no. dwelling units

Commercial _____ Industrial _____

New _____ Add'n. _____ Alter _____ Remodel _____

Mixed Occupancy _____

Change of Occupancy _____

Estimated Cost \$ _____

ZONING INFORMATION

district	lot dimensions	area	front yd	side yds	rear yd
max hgt	no pkg spaces	no ldg spaces	max cover	petition or appeal req'd	date appr

WORK INFORMATION:

Size: Length _____ Width _____ Stories _____ Ground Floor Area _____
 Height _____ Building Volume (for demo. permit) _____ cu. ft.

Electrical: _____
brief description

Plumbing: _____
brief description

Mechanical: _____
brief description

Sign: _____ Dimensions _____ Sign Area _____
type

Additional Information: _____

Date 9-21-89 Applicant Signature Ronald E Babcock
owner-agent

PAID
SEP 21 1989
 CITY OF NAPOLEON

FEES	BASE	PLUS	TOTAL
<input type="checkbox"/> BUILDING			
<input type="checkbox"/> ELECTRICAL			
<input type="checkbox"/> PLUMBING			
<input type="checkbox"/> MECHANICAL			
<input type="checkbox"/> DEMOLITION			
<input type="checkbox"/> ZONING			
<input type="checkbox"/> SIGN			
<input type="checkbox"/> WATER TAP			
SEW. INSP.			60.00
SEWER TAP			
TEMP. WATER			
TEMP. ELECT.			
ADDITIONAL PLAN REVIEW	Struct. _____ hrs	Elect. _____ hrs	
TOTAL FEES.....			60.00
LESS MIN. FEES PAID _____			
BALANCE DUE.....			

SEWER TAPPING PERMIT

Issued by

The City of Napoleon Engineering Dept.

255 West Riverview Ave. Napoleon, Ohio 43545 Pn. 592-4010

Entry No. _____

Permit No. ⁰¹¹⁰ ~~S.A. 0125-89~~ Issued 9-22-89 Build. Permit No. 01839

Permit Fee \$ 60.00

Job Location 1024 Sheffield

Street Bond \$ _____

Lot 61 HIGHLANDS 2ND ADD
sub div. or legal disc.

Date Paid 9-21-89

Issued By F

Owner Tom ROSAK Pn. _____

Address P.O. BOX 682

Agent C.F. Plumbing & Heating Pn. 592-0306

Address 403 E. Washington Napoleon, Ohio

for office use only

WORK INFORMATION

Sanitary Sewer Tap _____ Size of Tap _____ Size and Type of Sewer _____ Street to be Opened

Storm Sewer Tap Size of Tap _____ Size and Type of Sewer _____ Street to be Opened

Street opening Agreement Approval Date _____ Opening Bond Fee (Set by Engineer) _____

READ AND SIGN BELOW; The undersigned hereby agrees complete the work described above and to make use of said sewers only as allowed by and in strict accordance with all applicable provisions of The Napoleon Engineering Dept. Rules and Regulations, The Napoleon Standard Specification for Water Main, Sanitary Sewer and Storm Sewer Construction and other Pertinent Sections of the Napoleon Code of Ordinances.

Date 9-21-89 Signature of Applicant Donald E Babcock

Permit not valid without signature

INSPECTION RECORD _____ to be completed by the Field Inspector


Date Inspection is made 9-22-89 Size and Type of Sewer 9" CDR 31- ASTM JOIF

Location SEE PLAN Depth _____ Type of Test _____ Additional Information _____

Date 9-22-89 Inspected By [Signature]
signature of inspector

Sketch Of Installation on Back or Attached

PAID
SEP 21 1989
CITY OF NAPOLEON

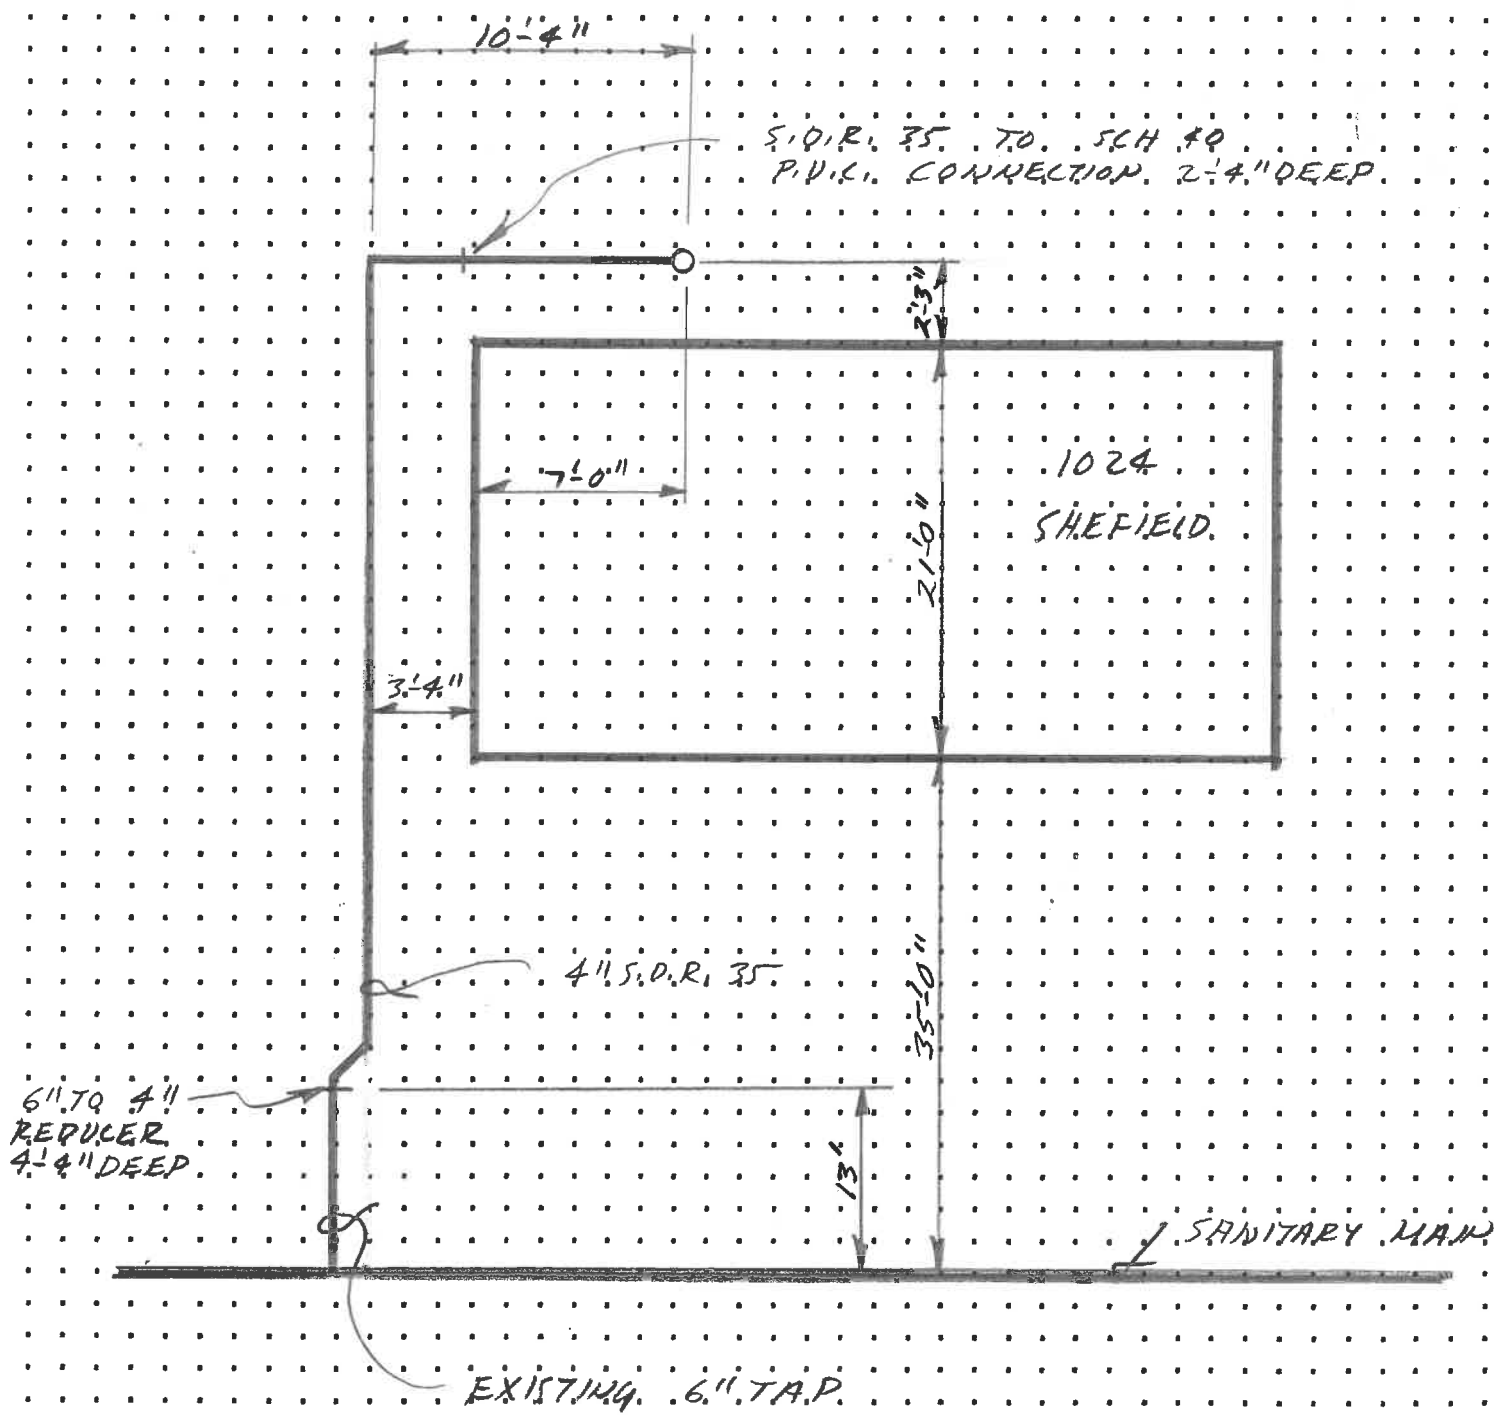

01A9
 000 12 517
 000 12 517