

APPLICATION FOR PERMIT TO TAP SEWER

(Print or Type)

Owner MARC HOUTS
Address 1123 N. SHEFFIELD
Contractor BECKS CONSTRUCTION
Address _____ Tel. _____

NO. _____
BLDG. PERMIT _____
PERMIT FEE \$ _____
DATE PAID _____
for office use only

LOCATION OF CONNECTION

Street and No. 1123 SHEFFIELD Sanitary Storm _____
Lot No. _____ Subdivision _____ Size of Tap 6"
Size and Type of Sewer PVC

ALL WORK MUST BE INSPECTED

I certify that the sewer will be used only as indicated and no other Drainage will be connected.

Date _____ Signature _____
owner-builder agent


do not write below this line

INSPECTION RECORD

Date Inspected _____ Size and Type of Sewer 4" PVC
Location REAR to FRONT Depth 9' @ tap Type of Test N/A
Inspected and Approved By: _____
Additional Information No SEPTIC TANK NOT INSPECTED Inspector _____ Date _____

Send copy to: MARC HOUTS - 1123 SHEFFIELD

SKETCH OF INSTALLATION

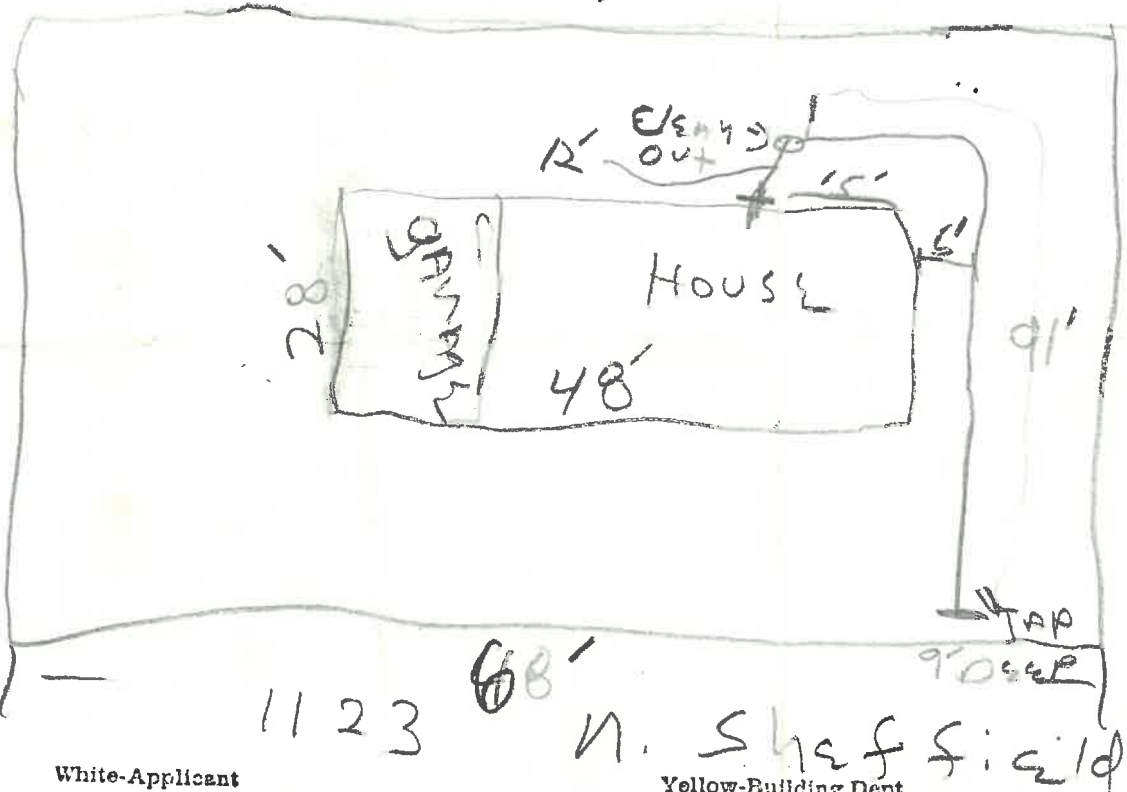

White-Applicant

Yellow-Building Dept.

Pink-Clerk-Treasurer