

SEWER TAPPING PERMIT

Issued by

The City of Napoleon Engineering Dept.

255 West Riverview Ave. Napoleon, Ohio 43545 Pn. 592-4010

Entry No. _____

Permit No. **00419** Issued 3-1-93 Build. Permit No. _____

Job Location 1013 Stevenson

Lot _____ sub div. or legal disc.

Issued By BND

Owner Richard Elling Pn. 598-8216

Address T-210 Top Rd 15B

Agent Bob Cordes Plbg. Pn. 758-3162

Address 17-706 Q-1 Napoleon

Permit Fee \$ 15.00

Street Bond \$ _____

Date Paid 3-3-93

for office use only

WORK INFORMATION

Sanitary Sewer Tap _____ Replace existing sewer Size of Tap _____ Size and Type of Sewer _____ Street to be Opened _____
 yes no
 Storm Sewer Tap _____ Size of Tap _____ Size and Type of Sewer _____ Street to be Opened _____
 yes no
 Street opening Agreement Approval Date _____ Opening Bond Fee (Set by Engineer) _____

PAID
MAR 02 1993
CITY OF NAPOLEON

READ AND SIGN BELOW; The undersigned hereby agrees complete the work described above and to make use of said sewers only as allowed by and in strict accordance with all applicable provisions of The Napoleon Engineering Dept. Rules and Regulations, The Napoleon Standard Specification for Water Main, Sanitary Sewer and Storm Sewer Construction and other Pertinent Sections of the Napoleon Code of Ordinances.



Date 3-1-93 Signature of Applicant Bob Cordes
Permit not valid without signature

INSPECTION RECORD _____ to be completed by the Field Inspector

Date Inspection is made _____ Size and Type of Sewer _____
Location _____ Depth _____ Type of Test _____ Additional Information _____

Date _____ Inspected By [Signature]
signature of inspector

Sketch Of Installation on Back or Attached

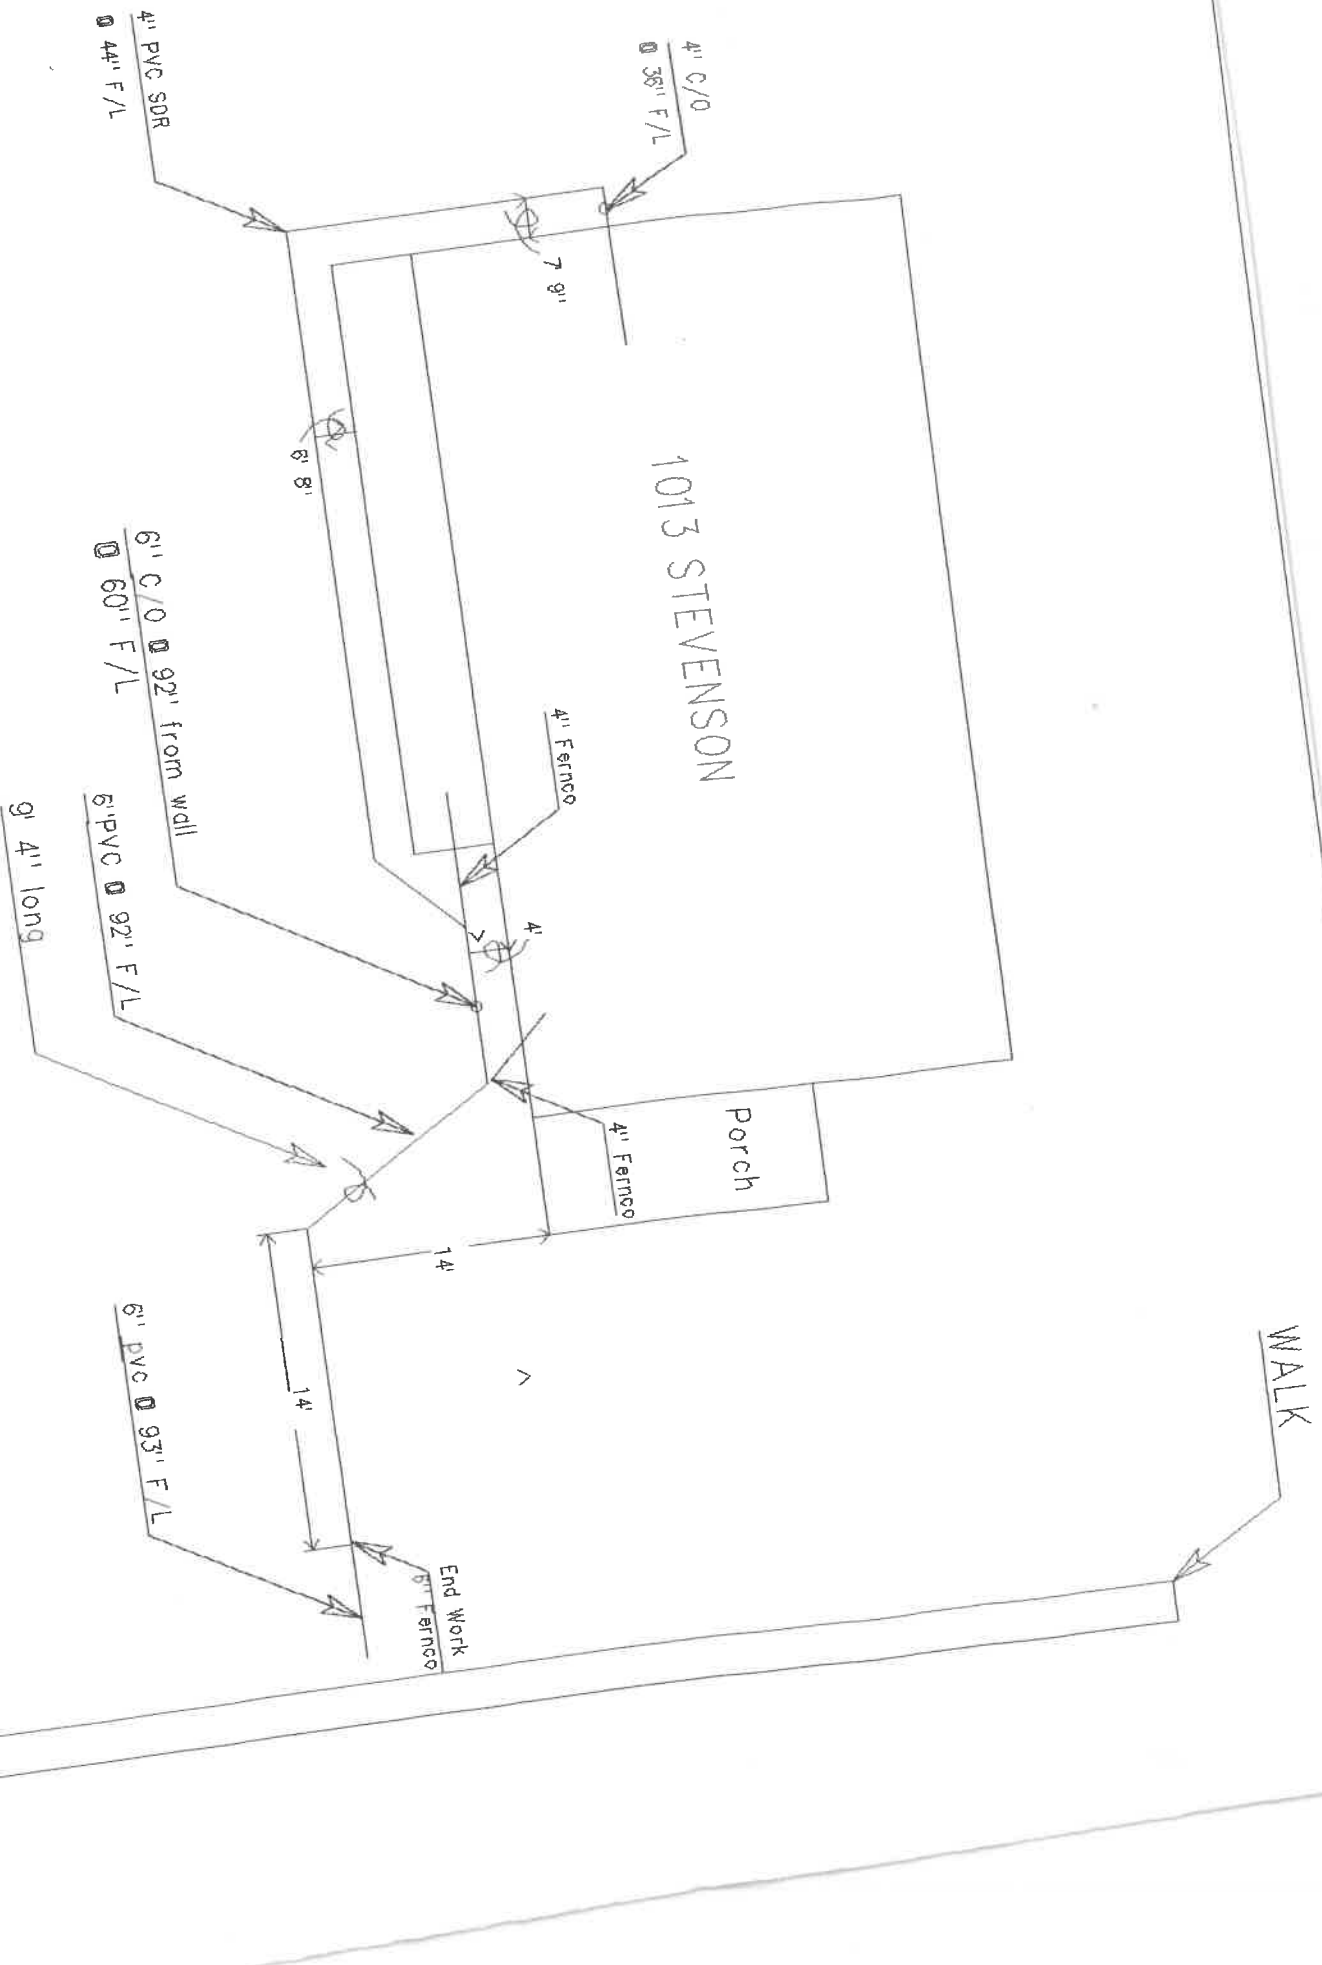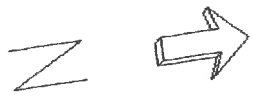

3-1-93

1013 Stevens Dr
Owner Richard Elling
Bob Cordes

