

APPLICATION FOR PERMIT TO TAP SEWER

(Print or Type)

Owner JUDY OKULY NO. _____
Address 1053 STEVENSON BLDG. PERMIT _____
Contractor MORT CORDES PERMIT FEE \$ _____
Address R4 NAPOLEON Tel. 78-3162 DATE PAID _____

for office use only

LOCATION OF CONNECTION
Street and No. 1053 STEVENSON Sanitary Storm _____
Lot No. 22 Subdivision MAXY DOODS 2ND ADD Size of Tap 1 1/2"
Size and Type of Sewer 10" PVC ALL WORK MUST BE INSPECTED


I certify that the sewer will be used only as indicated and no other Drainage will be connected.
Date 5/30/79 Signature Robert Cordes owner-builder agent
do not write below this line

INSPECTION RECORD

Date Inspected MAY 30, 1979 Size and Type of Sewer 4" PVC
Location BACK OF HOUSE Depth 6' @ TAP Type of Test NONE
Inspected and Approved By: Bruce Weirauch Inspector Date 5/30/79
Additional Information SEPTIC TANK FILLED w/ SAND

Send copy to: JUDY OKULY

SKETCH OF INSTALLATION

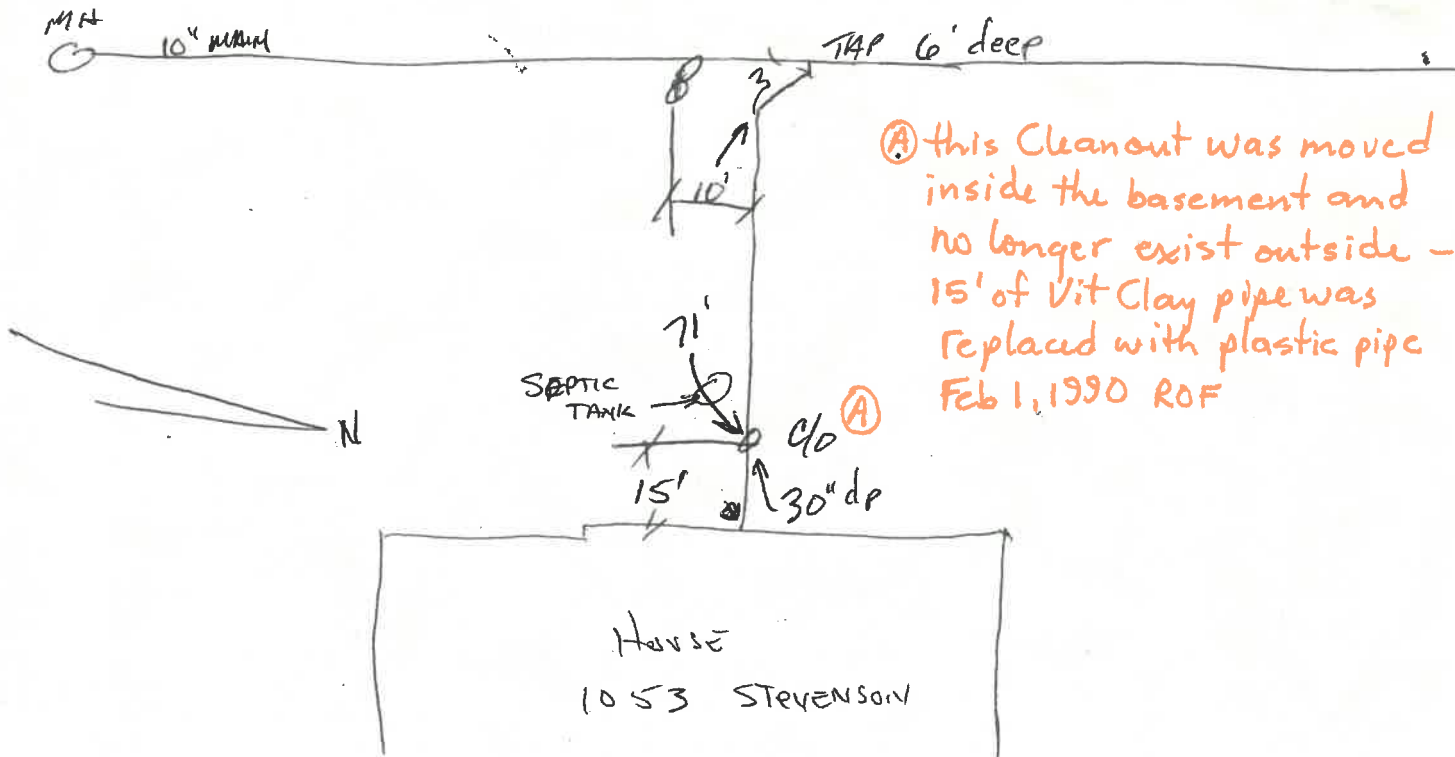

(A) this Cleanout was moved inside the basement and no longer exist outside - 15' of Vit Clay pipe was replaced with plastic pipe Feb 1, 1990 ROF