

APPLICATION FOR PERMIT TO TAP SEWER

(Print or Type)

Owner WILBUR CLARK NO. _____
Address RIVERVIEW NAPOLEON BLDG. PERMIT _____
Contractor MARVIN BEHNFEIDT PERMIT FEE \$ _____
Address R#4 NAPOLEON Tel. 758-3198 DATE PAID _____
for office use only

LOCATION OF CONNECTION

Street and No. 1104 STEVENSON Sanitary Storm _____

Lot No. _____ Subdivision _____ Size of Tap _____

Size and Type of Sewer 4" Oring ALL WORK MUST BE INSPECTED

I certify that the sewer will be used only as indicated and no other Drainage will be connected.

Date 6-25-79 Signature Marvin Behnfeldt
owner-builder agent

do not write below this line

INSPECTION RECORD

Date Inspected 6-25-79 Size and Type of Sewer 4" PVC

Location 1104 Stevenson Depth 4' ± Type of Test N/A



Inspected and Approved By: Von Berlin Inspector Date 6/25/79

Additional Information _____

Send copy to: Marvin Behnfeldt

SKETCH OF INSTALLATION

Tap-in at street was already made
Pumped tank, back-filled with yellow sand
and made hook-up with
4" Oring plastic - 7 1/2' long
through abandoned septic
tank

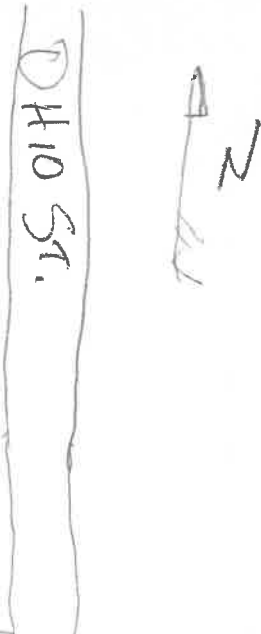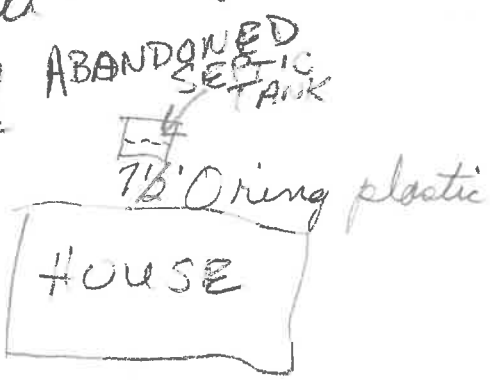

STEVENSON