
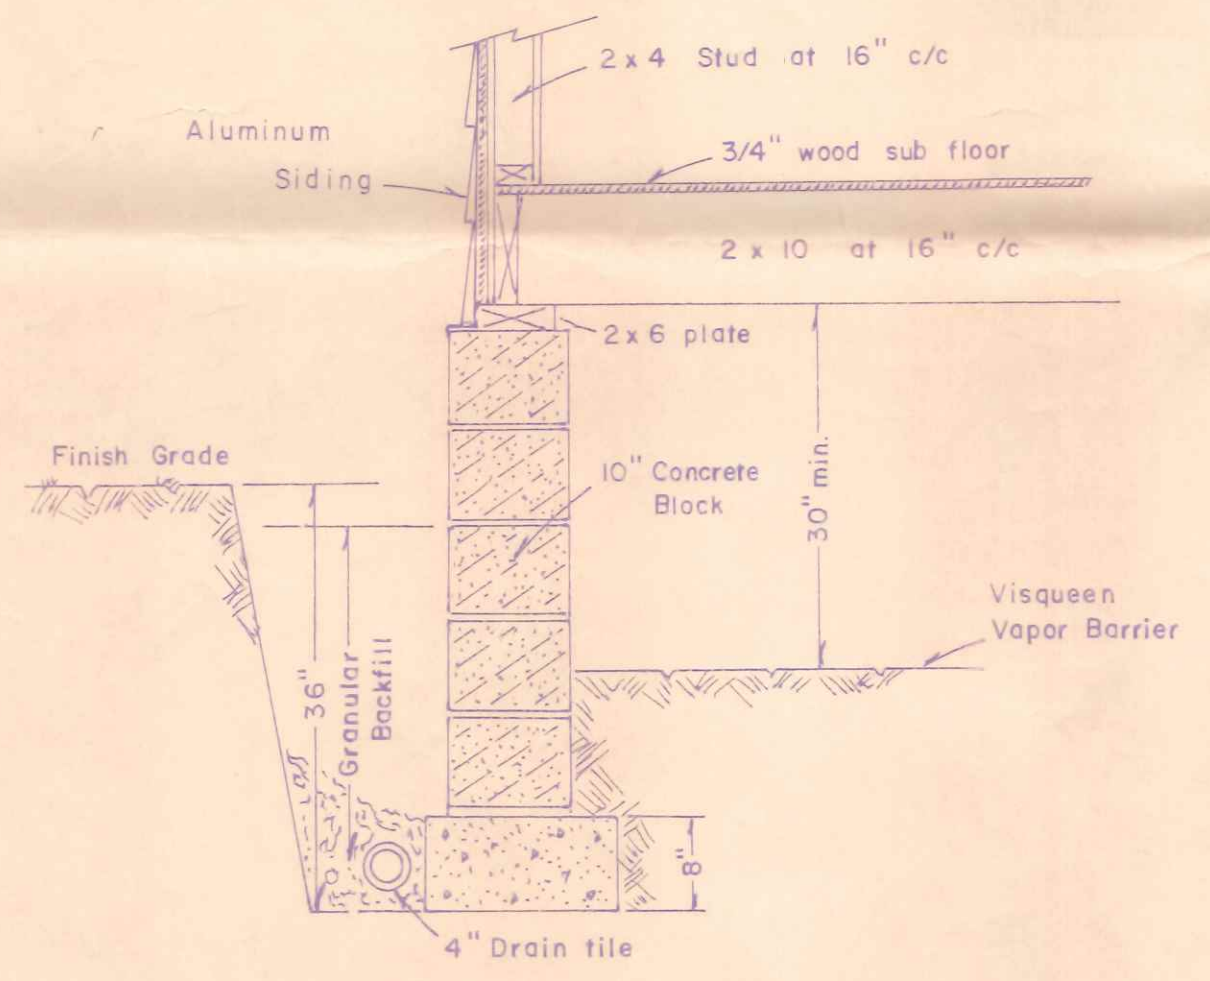



Lots 28-29-30  
Sycamore

BECK'S CONSTRUCTION  
R.R. # 3  
NAPOLEON, OHIO

1760 ~~sq.~~ sq. ft. GROSS AREA  
400 sq. ft. GARAGE  
1360 ~~sq.~~ sq. ft. NET LIVING AREA

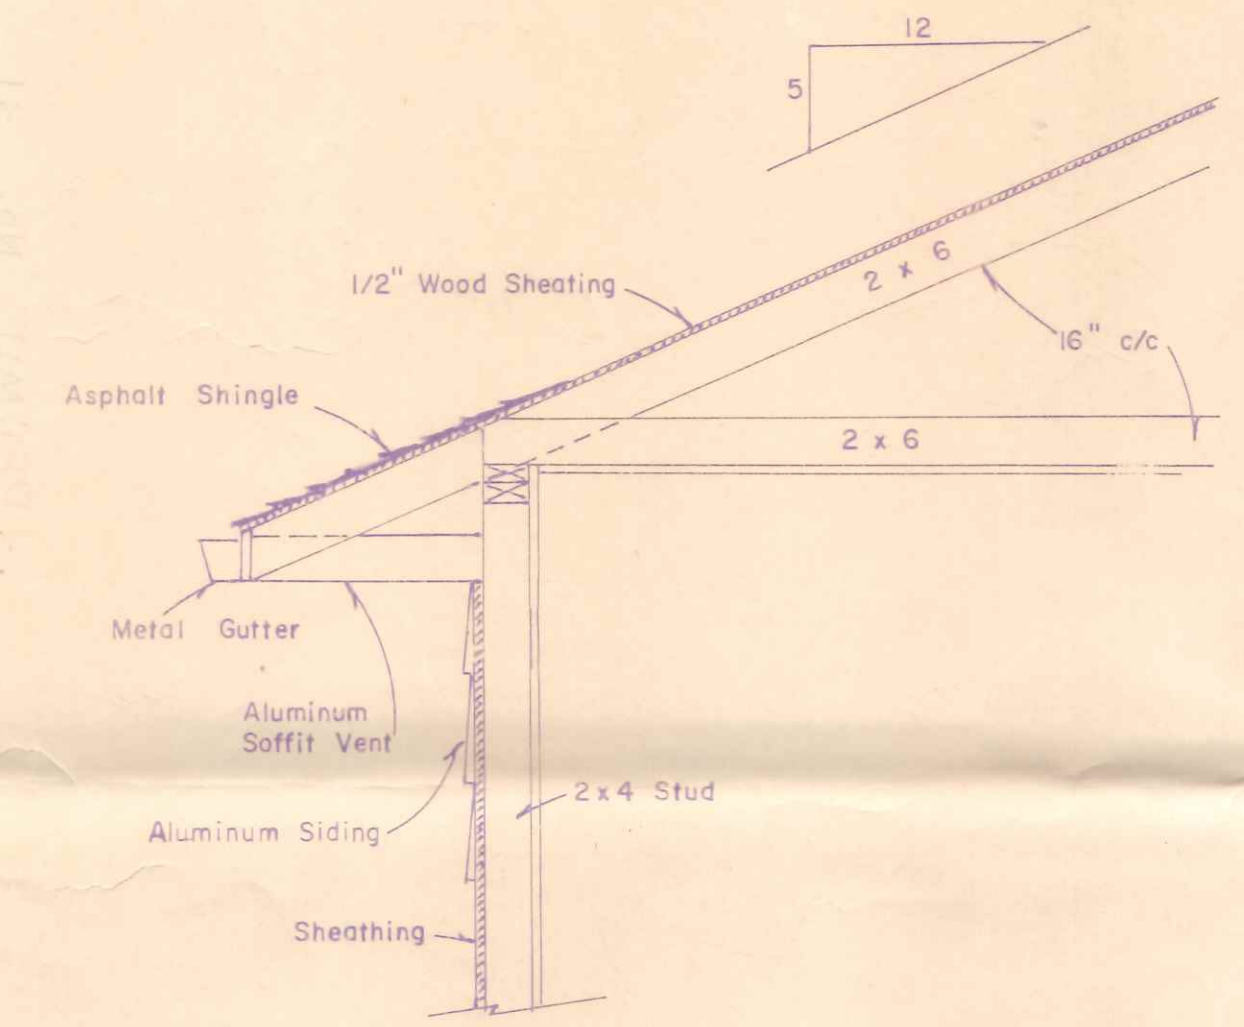

WALL SECTION DETAIL

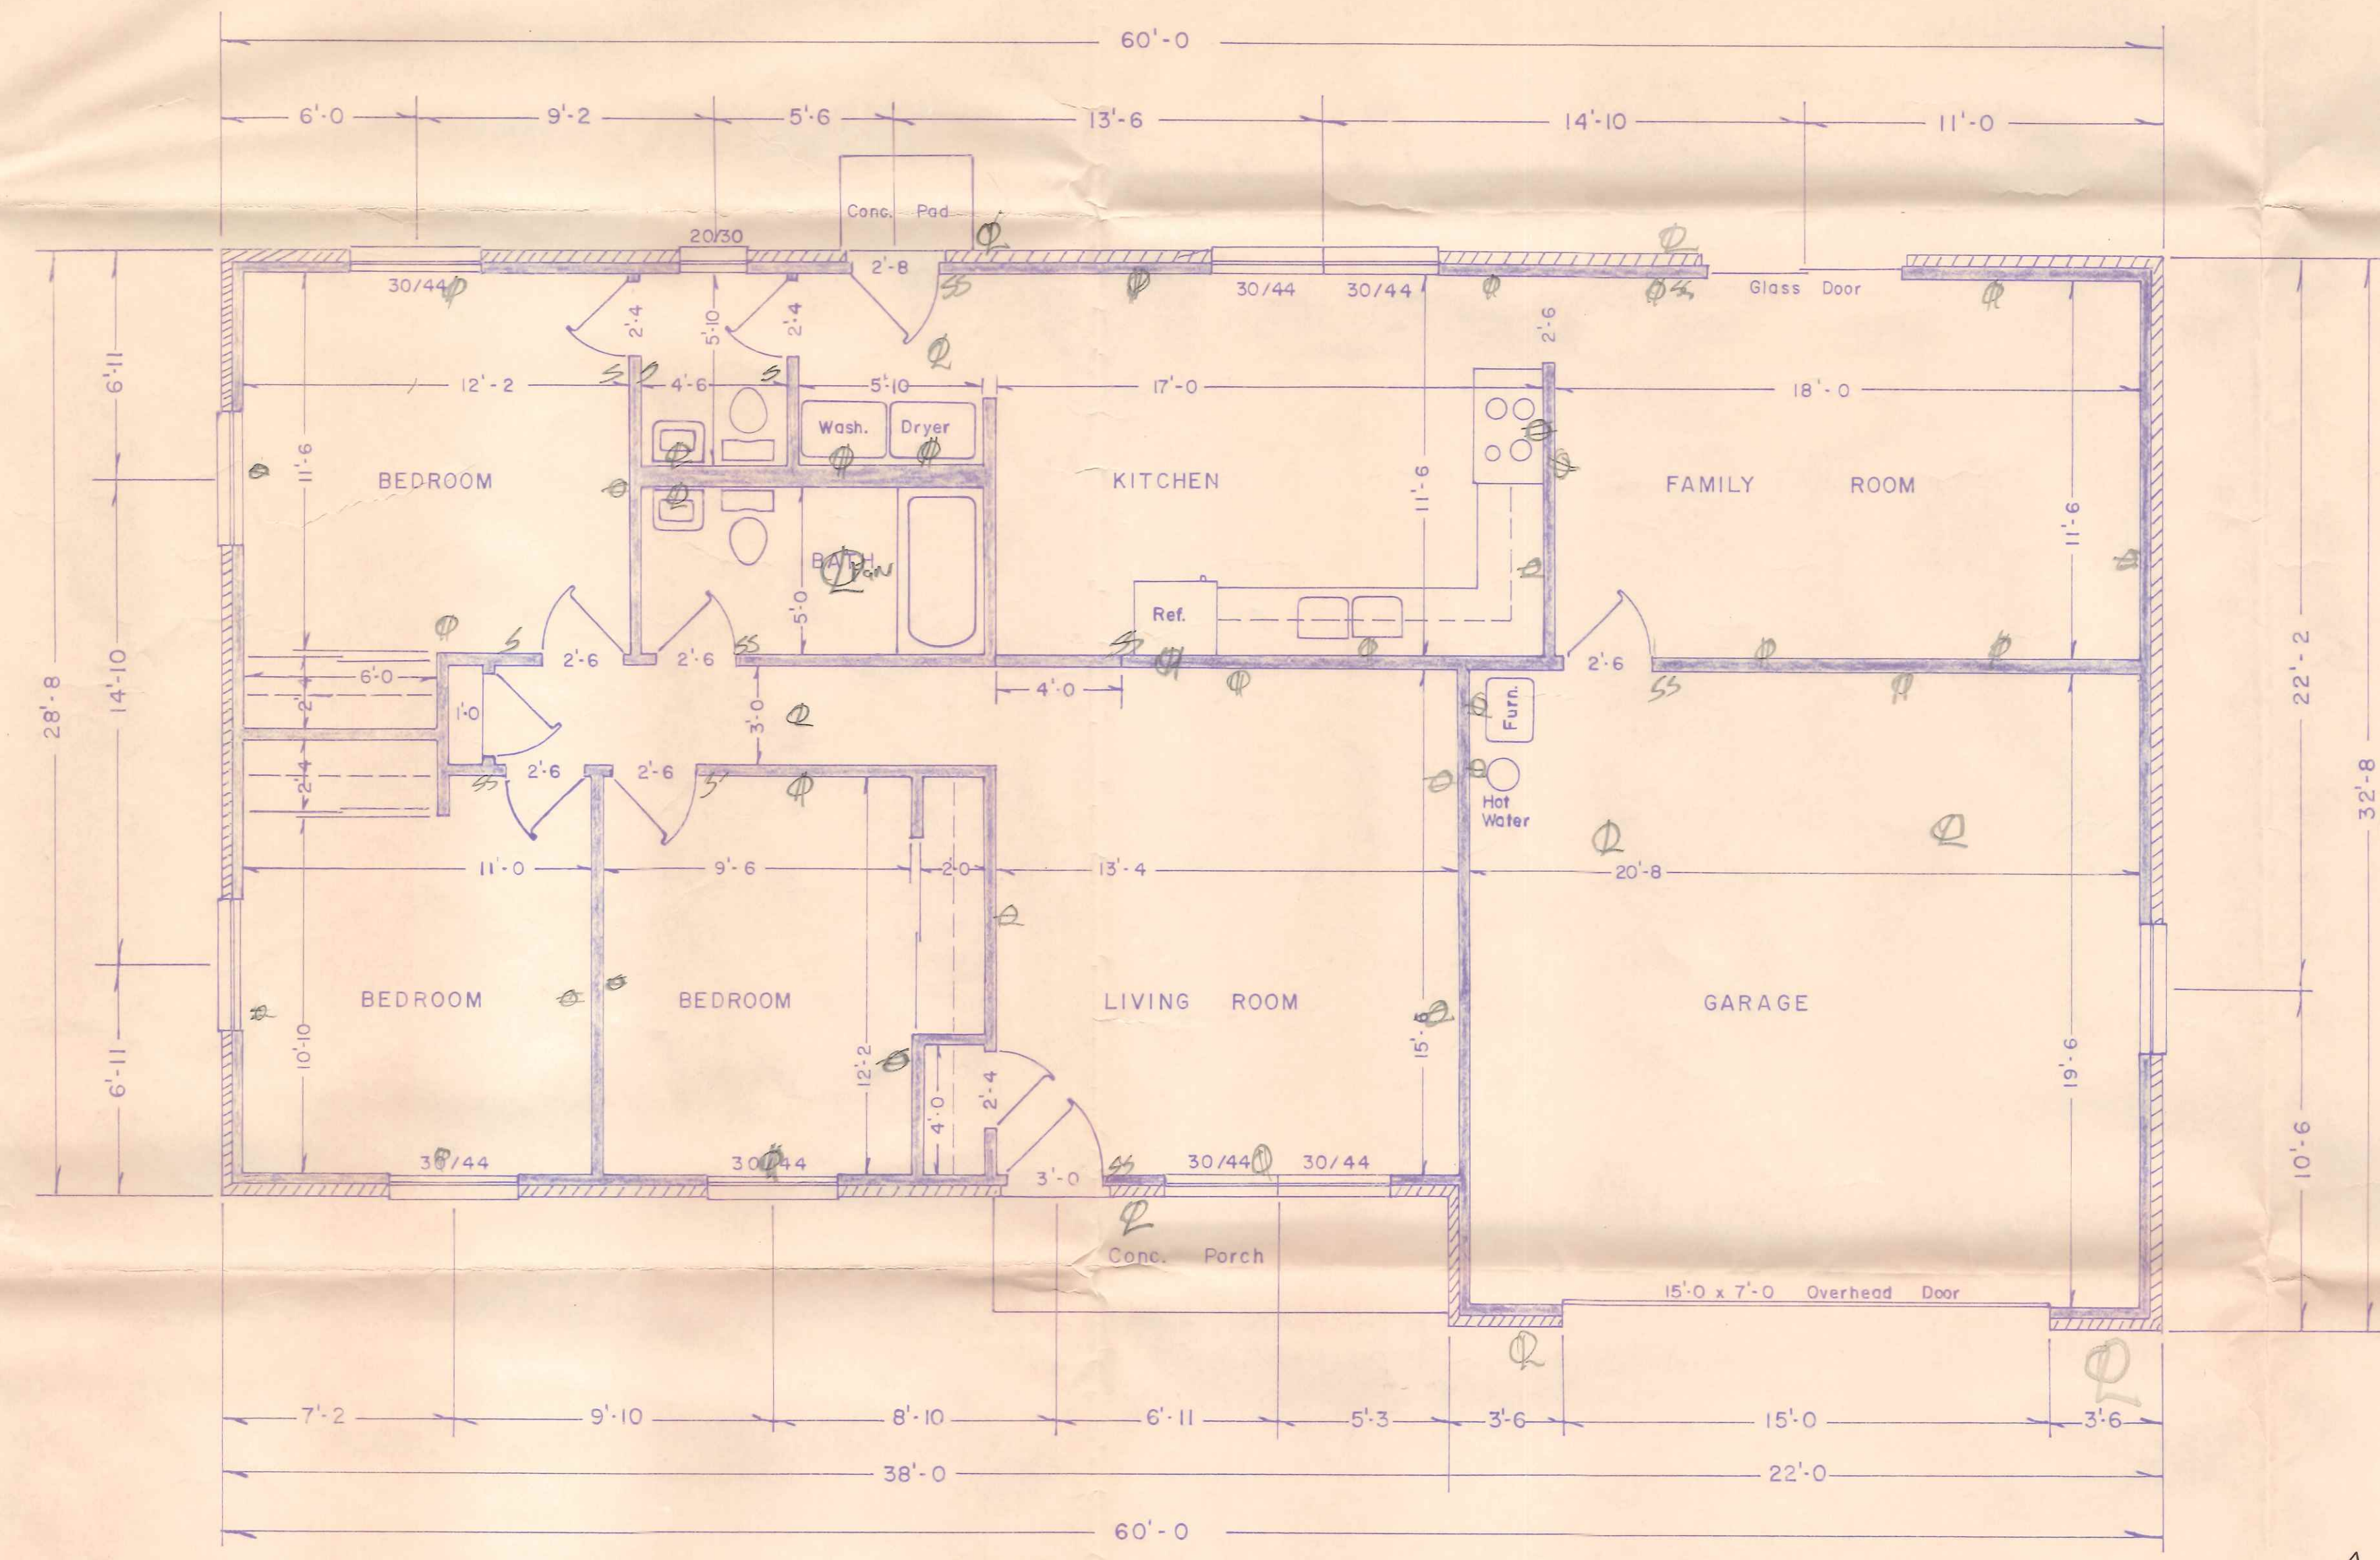

FLOOR PLAN  
Scale: 1/4" = 1'

- NOTE: Exterior finish brick  
 Roof pitch 5" in 12"  
 Roof overhang 2'-8"  
 Rafter & ceiling joist 2" x 6"  
 Floor joist 2" x 10"  
 Subfloor 3/4" plywood  
 3 1/2"-10" block on 8" x 16" footer

1117 Sycamore Dr.