

THE CITY OF NAPOLEON

BUILDING & ZONING DEPARTMENT

255 W. RIVERVIEW

(419) 592-4010

Building Permit

Page 1 of 1

Permit Number: BP2009-104

Printed: 9/22/2009

ADDRESS:

95 Vincennes Dr

Applicant

Name: Andrew Hunter
Address: 95 Vincennes Dr.

Approval Date: 6/2/2009
419-822-7759

Owners

Name: Mr. Andrew Hunter
Address: 95 Vincennes Dr.
Napoleon, OH 43545

Phone: 419-822-7759

Contractors

Fees and Receipts:

Number	Description	Amount
FEE2009-492	Building	\$25.00
FEE2009-493	State 1% fee (Calc)	\$0.25
	Total Fees:	\$25.25
RCPT2009-333		\$25.25
	Total Receipts:	\$25.25

12'x18' Deck

APPLICANTS SIGNATURE: _____ DATE: _____

REMINDER: YOU MUST CALL (419)592-4010 FOR AN INSPECTION

CITY OF NAPOLEON GENERAL PERMIT APPLICATION

THIS APPLICATION IS FOR RESIDENTIAL CONSTRUCTION INCLUDING BUILDING, ELECTRICAL, PLUMBING, MECHANICAL, DEMOLITIONS & REMODELING

DATE 6/2/09 JOB LOCATION 95 Vincennes Dr.
 OWNER Andrew Hunter TELEPHONE # 419-822-7759
 OWNER ADDRESS ~~XXXXXXXXXXXXXXXX~~ 95 Vincennes Dr. Napoleon Ohio
 CONTRACTOR Matthew Hunter CELL PHONE # 567-454-0533
 DESCRIPTION OF WORK TO BE PERFORMED A 12ft x 18ft Deck that will be approximately 1ft high.
 ESTIMATED COMPLETION DATE 6/7/09 ESTIMATED COST \$1,300.00

Affected Floor Area (AFA): In existing structures, it is the area affected by the improvement, i.e. a new wall dividing a room (the AFA would be only the room and not all the rooms).

DESCRIPTION	FEE	TOTAL COST
<i>Addition & Alterations</i> Square foot in (AFA) x \$0.05 = \$	+	\$25.00 = \$
<i>Electrical</i> Circuits in (AFA) x \$3.00/Circuit = \$	+	\$25.00 = \$
<i>Plumbing</i> Traps in (AFA) x \$3.00/Trap = \$	+	\$25.00 = \$
<i>Siding and/or Roofing</i>		\$25.00 \$
<i>Windows/Doors</i>		\$25.00 \$ 25.00
<i>Decks</i>		\$25.00 \$ <u>25.00</u>
<i>Garage and Shed over 250 SF (Detached)</i>		\$25.00 \$
<i>Electrical Service Upgrade</i>		\$25.00 \$
<i>Water Heater</i>		\$25.00 \$
<i>Furnace and/or AC Replacement</i>		\$25.00 \$
	MBP (100.3100.46510)	Subtotal: \$ <u>25.00</u>
	(100.0000.42700) PLUS Ohio Board of Building Standards Fee + 1%	\$ <u>25.25</u>

TOTAL FEE: \$ 25.25

I FULLY UNDERSTAND THAT NO EXCAVATION, CONSTRUCTION OR STRUCTURAL ALTERATION, ELECTRICAL OR MECHANICAL INSTALLATION OR ALTERATION OF ANY BUILDING STRUCTURE, SIGN, OR PART THEREOF AND NO USE OF THE ABOVE SHALL BE UNDERTAKEN OR PERFORMED UNTIL THE PERMIT APPLIED FOR HEREIN HAS BEEN APPROVED AND ISSUED BY THE CITY OF NAPOLEON BUILDING/ZONING DEPARTMENT.

I hereby certify that I am the Owner of the named property, or that the proposed work is authorized by the Owner of record and that I have been authorized by the Owner to make this application as his/her authorized agent and I agree to conform to all applicable laws of the jurisdiction. In addition, if a permit for Work described in this application is issued, I certify that the code official or the code official's authorized representative shall have the authority to enter areas covered by such permit at any reasonable hour to enforce the provisions of the code(s) applicable to such permit.

I HEREBY ACKNOWLEDGE THAT I HAVE READ AND FULLY UNDERSTAND THE ABOVE LISTED INSTRUCTIONS.

SIGNATURE OF APPLICANT: Matthew Hunter DATE: 6/2/09

PRINT NAME: Matthew Hunter


BATCH # 20786 CHECK # 5971 DATE 06-03-09

95 W. B. (crossed out)

LOT 95

SITE PLAN FOR
BECKS CONSTRUCTION, CO.

LOT NO. 97, RIVIERA HEIGHTS SUB-DIV
4TH ADD'N., CITY OF NAPOLEON, HENRY CO., OHIO.

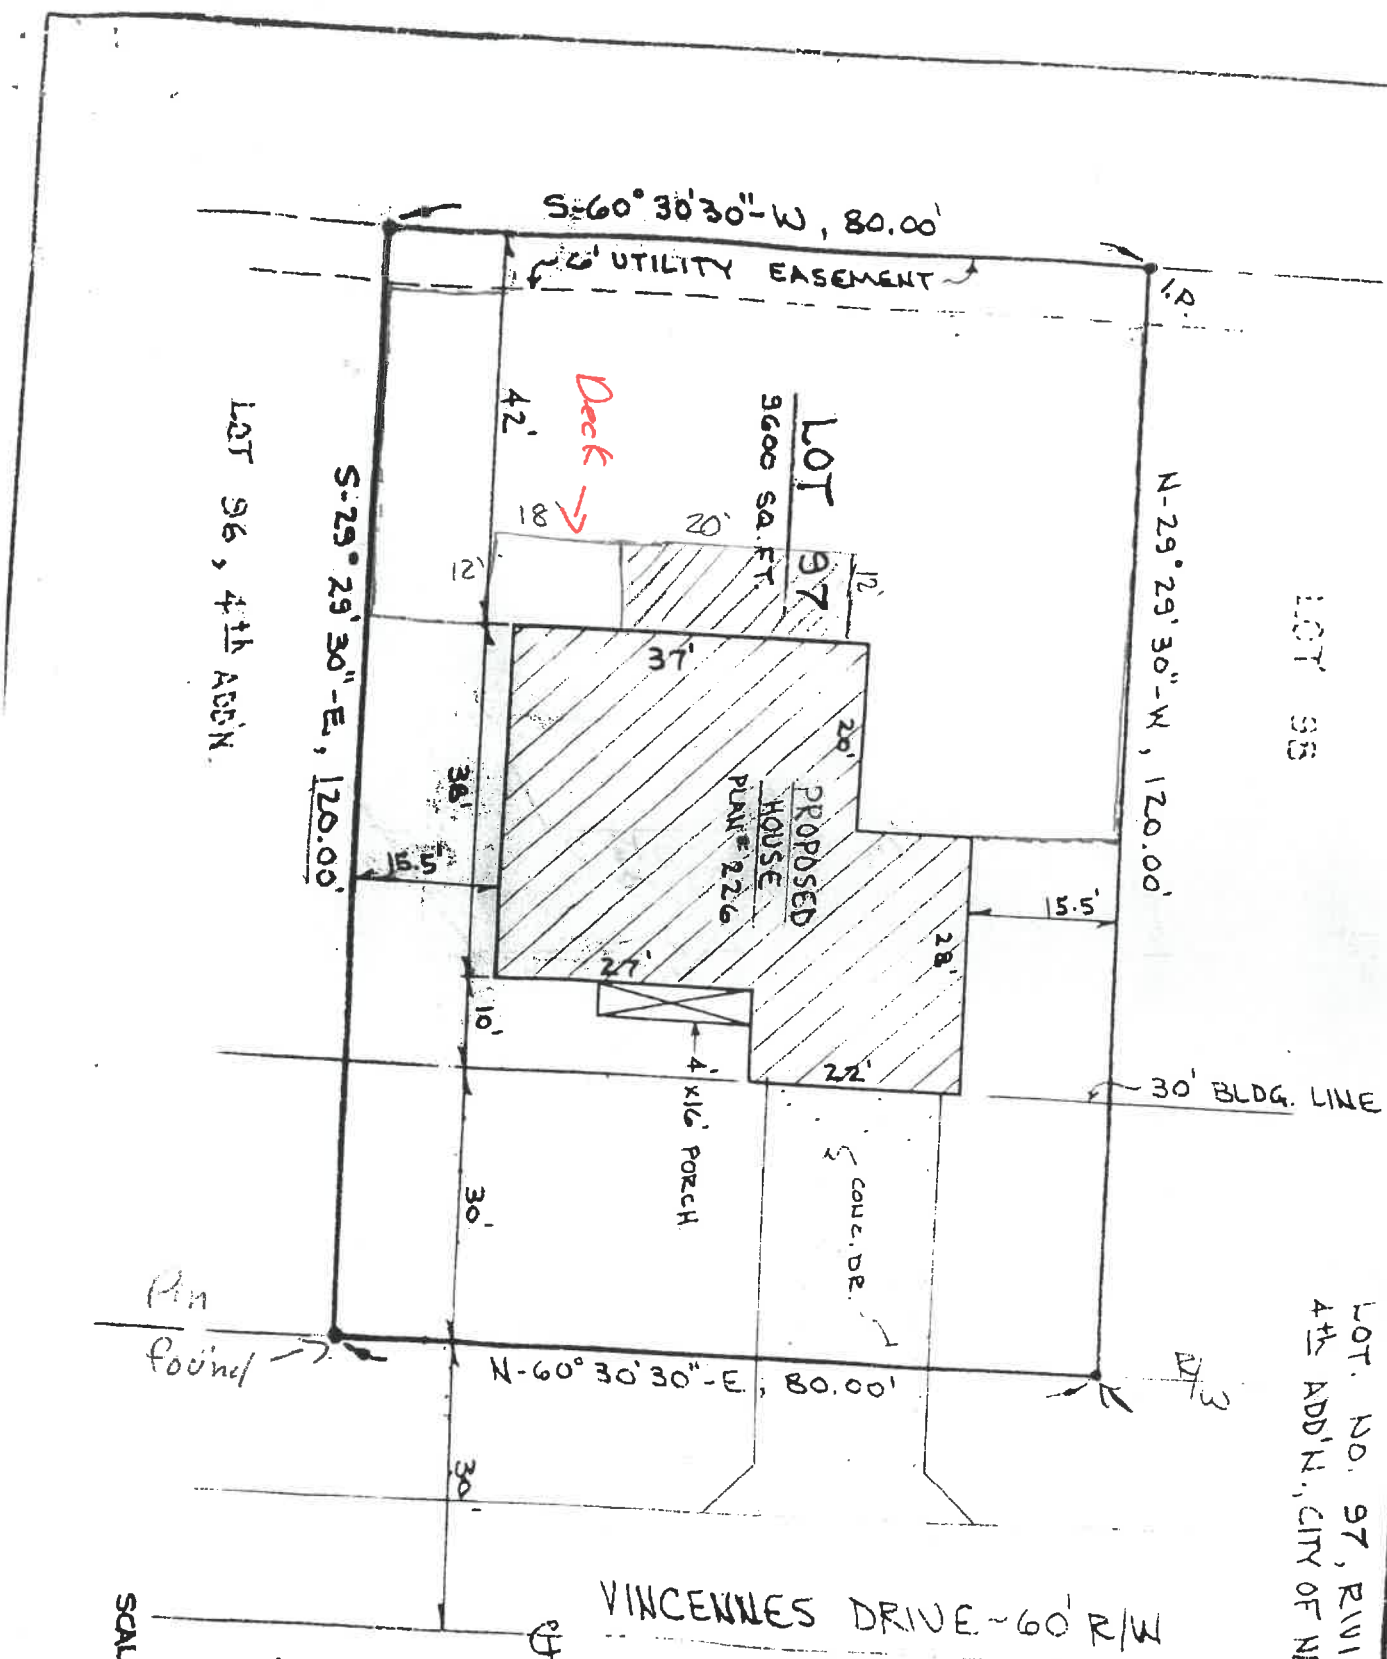


S-60°30'30"-W, 80.00'

N-29°29'30"-W, 120.00'

S-29°29'30"-E, 120.00'

N-60°30'30"-E, 80.00'


SCALE: 1" = 20'

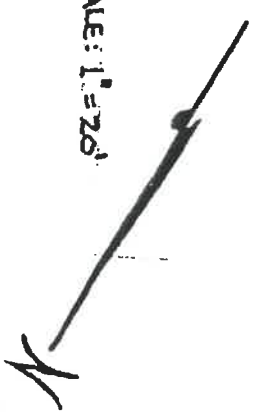

We decided against the angled corner on the deck, and we decided to go with your idea of hinging the fence and attaching it to the neighbors. Thanks, If you have any questions my cell # is (567) 454-0533.

Thanks.

Matt Hunter

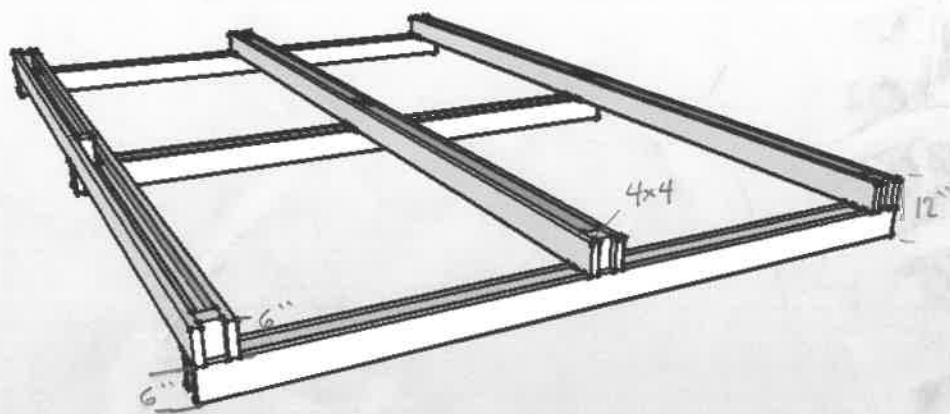

2 1/2 ft in ground