

**CITY OF NAPOLEON
BUILDING CONSTRUCTION PERMIT**

(1, 2 or 3 Family Dwelling)

Owner Name Bernard Barger

Address 511 Vine St.

Builder Name Ford Heising Co.

Address Rt. 4, Napoleon Tel. 592-9158

Lot Information:

Street No. 511 Vine St.

Lot #2 Subdivision Hoy's Sub-Div.

Lot Dimensions 58x132 Lot Area 5,940 Sq. Ft.

Yard Set Back: Front ----- Rear Min. 15'

One Side 5', Total Side Not Less Than 9'

Zoning "B" Intended use of Building: Constructing to the rear of the existing dwelling, a 12'x20' enclosed wood frame porch.

Building Information:

Single Double Multiple New Construction Addition Remodel

Size: Length 20' Width 12' No. of Stories 1

Floor Area: 1st Floor 240sqft 2nd Floor -- 3rd Floor -- Basement --

Unfinished Attic Garage

Foundation: Piers Full Basement Part Basement

Concrete Block

Walls: Frame Block Brick Other Alum siding

Electrical: Wiring None Electric Heating None Electrical Appliances None

Plumbing: Fixtures or Traps --- Warm Air Heating --- Hot Water Heating ---

Additional Information: This permit requires compliance with the attached addendum marked exhibit "A" and made a part here-of.

Date ----- Applicant Signature -----

Owner - Builder - Agent

NOTE: NEW PORTION OF CONCRETE SLAB POURED PRIOR TO ISSUING OF THIS PERMIT.

Note: ~~1/5/76~~ 1/5/76 Electrical wiring done without obtaining permit or inspections. AWP

Inspection Record:

Work Started	Foundations	Plumbing, Heating
Set Back, Side Lines	Plumbing (Rough In)	And Air Conditioning
Excavation	Erecting Frame	Roof
Footing	Electrical Work

Comments: 1/5/76 Job completed, Siding not grounded as instructed Heising on 9/24/75. AWP


Certificate of Occupancy Issued -----

Pink - Engineer

Inspector

Permit No.	<u>380-75</u>		
Issued	<u>9/23/75</u>		
By	<u>Thomas W. Brennan</u> Building Inspector		
Valuation	<u>\$3,200.00</u>		
	Fees	Base	Plus
Construction	<u>\$12.00</u>	<u>--</u>	<u>\$12.00</u>
Plumbing	<u>-----</u>	<u>-----</u>	<u>-----</u>
Electrical	<u>-----</u>	<u>-----</u>	<u>-----</u>
Heating	<u>-----</u>	<u>-----</u>	<u>-----</u>
Water Tap	<u>-----</u>	<u>-----</u>	<u>-----</u>
Sewer Tap	<u>-----</u>	<u>-----</u>	<u>-----</u>
Temporary Elec.	<u>G.F.I.C. REQUIRED</u>		
TOTAL	<u>\$12.00</u>	<u>--</u>	<u>\$12.00</u>

NOT TRAN.

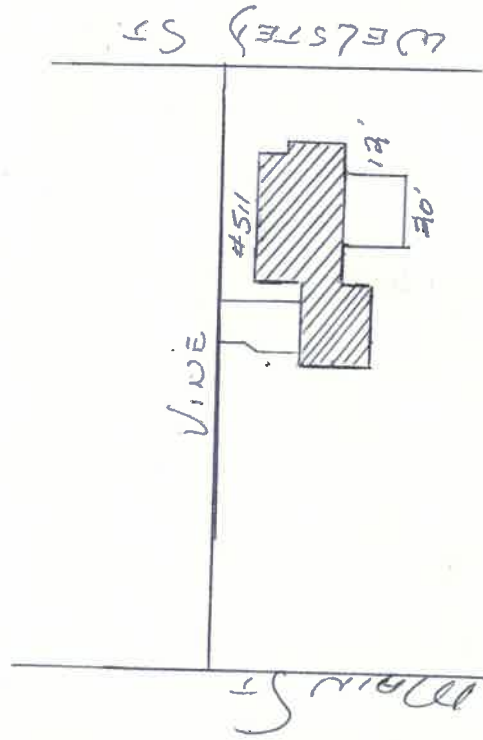

CITY OF NAPOLEON
 ENGINEERING DEPT.
 PLAN APPROVAL
 BY: [Signature] DATE: 7/23/75


News slab poured prior to
 issuing of permit. [Signature]

ENCLOSED PORCH ADDN. 12' x 90'

FOR MR & MRS B BARRER

511 VINE ST NAPOLEON, O.

CONTR. HEISWIC SUPPLY CO. INC.

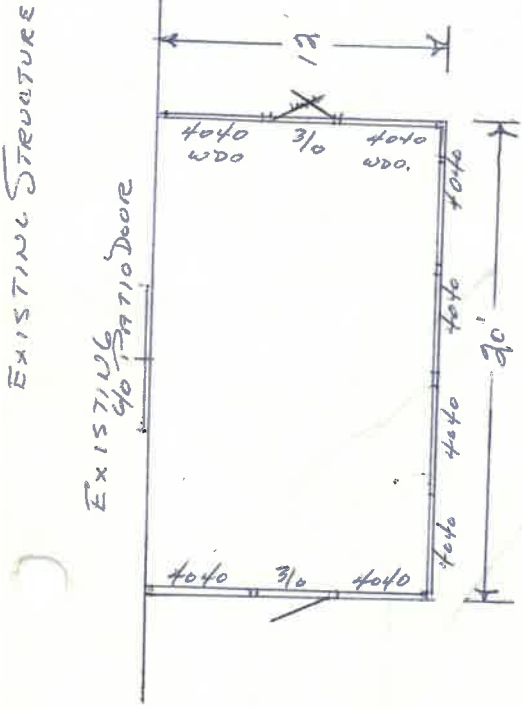

CAREY FIREFLEX BILT-UP ROOF SYSTEM.
 15# FELT
 1/2 PLYWD CDX SHEATHING.
 2x6 WALL NAILED JOIST HANGERS

ALUM GUTTER.
 ALUM FACIA
 1x6 SUB-FACIA
 2x4 PLATE
 DBL 2x12 HEADER LAMINATED. (PERIMETER OF BLDG)
 4x4 WDO
 8" ALUM SIDING
 1/2 CDX FLP
 2x4 STUDS 16" OC
 2x4 PLATE BOLTED
 SILL SEALER
 EXISTING CONCRETE

(NOT TO SCALE)

DRAWN BY F. HEISWIC

45 X 132

new portion of footer
slab poured prior
to issuing of permit.

CITY OF NAPOLEON
ENGINEERING DEPARTMENT
APPLICATION FOR CONSTRUCTION PERMIT
(PLEASE PRINT OR TYPE)

The undersigned hereby makes application for the construction, installation, replacement or alteration as herein specified, agreeing to do all such work in strict accordance with the City of Napoleon's Building Code for 1, 2 and 3 Family Buildings.

Owner's Name BERNARD BARGER Address 511 VINE ST.
Builder's Name FERT HEISING Address Rt 4 Nap Tel. 592-9138

NOT INFORMATION: (Not required for roofing or siding job.)

Location of Project SAME Lot # 2

Subdivision Hoy's Sub Div Outlot 13 Lot Area _____ Sq. Ft. _____

Yard Set Back: Front _____ Rear _____ Left Side _____
Right Side _____ Zoning District _____

BUILDING INFORMATION:

Single Double _____ Multiple _____ New Construction _____

Addition Remodel _____ Attached Garage _____

Detached Garage _____ Accessory Building _____ Replacement _____

Brief Description of Work: ENCLOSED PORCH

Size: Length 20 Width 12 No. of Stories 1

Floor Area: 1st Floor 240 Sq. Ft. 2nd Floor _____ Sq. Ft. _____

3rd Floor _____ Sq. Ft. Basement 1 Sq. Ft. _____

Unfinished Attic _____ Garage _____

Foundation: Piers _____ Full Basement _____ Pore Basement _____

Concrete Thickness Block _____ Size _____

Walls: Frame Block _____ Brick _____ Other _____

Specific Type of Exterior Siding ALUMINUM

APPLICATION FOR PERMIT SHALL BE ACCOMPANIED BY TWO COMPLETE SETS OF PLANS INCLUDING: ELEVATIONS, FLOOR PLANS, CROSS SECTIONS AND PLOT PLAN. IF ADDITIONS OR REMODELING, SHOW ALL EXISTING STRUCTURES AND THEIR SIZE AND LOCATION. ALL PLANS SHALL BE DRAWN TO 3/4"=1'-0" SCALE. PLOT PLAN DRAWN TO 1/8"=1'-0" SCALE.

ESTIMATED COST OF COMPLETED PROJECT: 3200.⁰⁰

DATE 9-19-75 APPLICANT'S SIGNATURE Fert Heising
OWNER-BUILDER-AGENT

Cost of ~~Permit~~ Permit 12.⁰⁰