

SEWER TAPPING PERMIT

Issued by

The City of Napoleon Engineering Dept.

255 West Riverview Ave. Napoleon, Ohio 43545 Pn. 592-4010

Entry No. \_\_\_\_\_

Permit No. \_\_\_\_\_ Issued 9-18-95 Build. Permit No. \_\_\_\_\_

Job Location 214 ~~214~~ E. Washington

Lot \_\_\_\_\_

Issued By BIRD sub div. or legal disc.

Owner Paul Howe Pn. 592-4651

Address 214 E. Washington

Agent Mort Cordes Pn. 758-3855

Address 16-399 Rd. P-1 Napoleon

Permit Fee \$ 60.00

Street Bond \$ \_\_\_\_\_

Date Paid 9-18-95

for office use only

WORK INFORMATION

Sanitary Sewer Tap  Size of Tap 6" Size and Type of Sewer 6" PVC SDR35 Street to be Opened

Storm Sewer Tap \_\_\_\_\_ Size of Tap \_\_\_\_\_ Size and Type of Sewer \_\_\_\_\_ Street to be Opened \_\_\_\_\_

Street opening Agreement Approval Date \_\_\_\_\_ Opening Bond Fee (Set by Engineer) \_\_\_\_\_

READ AND SIGN BELOW; The undersigned hereby agrees complete the work described above and to make use of said sewers only as allowed by and in strict accordance with all applicable provisions of The Napoleon Engineering Dept. Rules and Regulations, The Napoleon Standard Specification for Water Main, Sanitary Sewer and Storm Sewer Construction and other Pertinent Sections of the Napoleon Code of Ordinances.

Date 9-18-95 Signature of Applicant \_\_\_\_\_ Permit not valid without signature

INSPECTION RECORD \_\_\_\_\_ to be completed by the Field Inspector

Date Inspection is made \_\_\_\_\_ Size and Type of Sewer \_\_\_\_\_

Location \_\_\_\_\_ Depth \_\_\_\_\_ Type of Test \_\_\_\_\_ Additional Information \_\_\_\_\_

Date 9-18-95 Inspected By [Signature] signature of inspector



Sketch Of Installation on Back or Attached

PAID  
SEP 19 1995  
CITY OF NAPOLEON

11/01/95

9-18-95

New sewer line

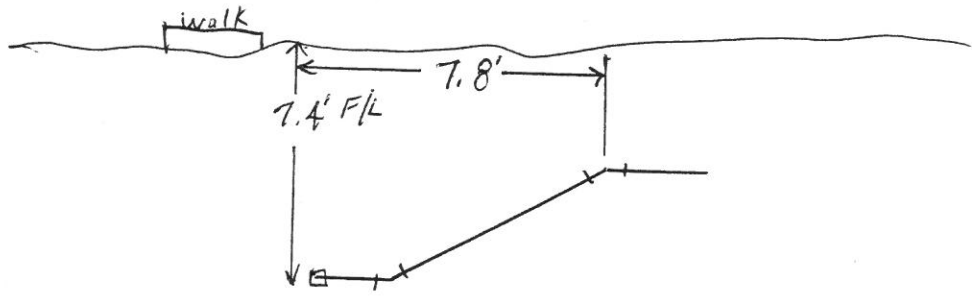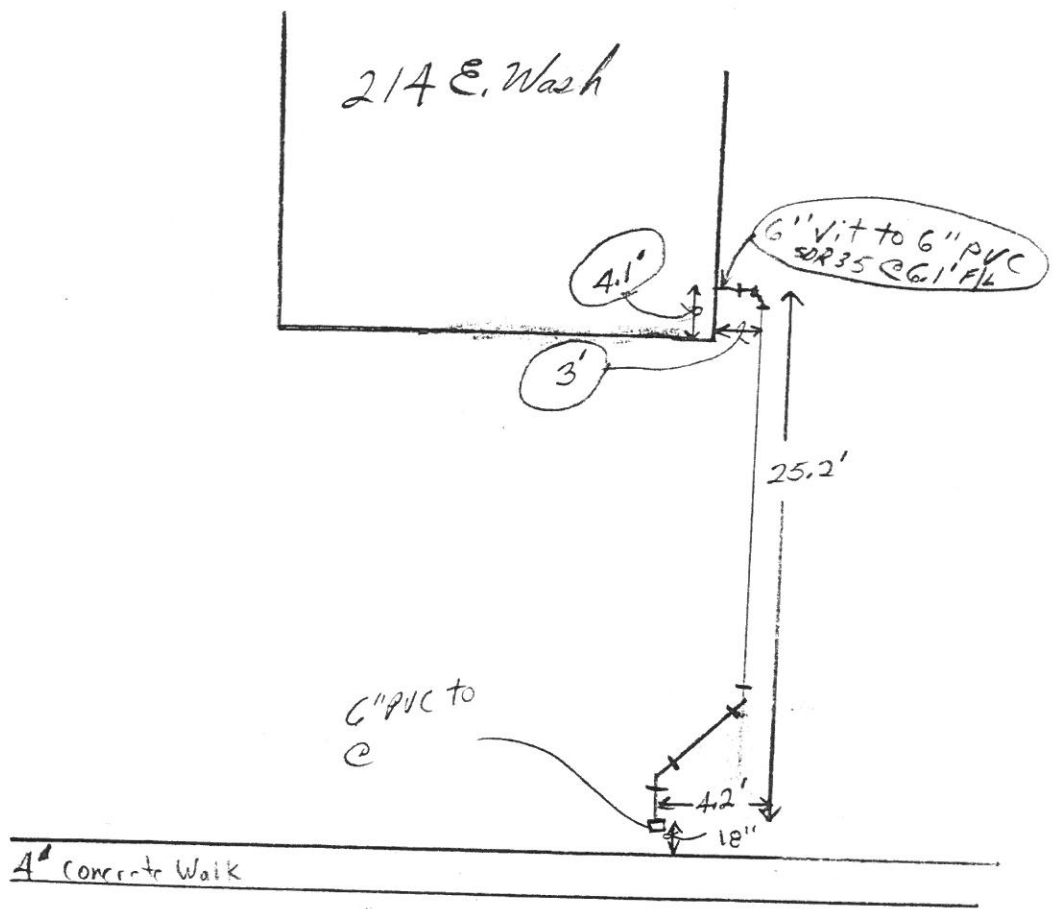

Mort Cordes

9-18-95

New sewer line

