

SEWER TAPPING PERMIT

Issued by

The City of Napoleon Engineering Dept.

255 West Riverview Ave. Napoleon, Ohio 43545 Pn. 592-4010

Entry No. \_\_\_\_\_

Permit No. SA0161 Issued 1-14-91 Build. Permit No. \_\_\_\_\_

Permit Fee \$ 35.00

Job Location 823 w. Washington

Street Bond \$ \_\_\_\_\_

Lot F Adam Stouts 1st.

Date Paid \_\_\_\_\_

Issued By Brent N. Damman sub div. or legal disc.

Owner Victor Lange Pn. 592-1646

Address 823 w. Washington

Agent Bill ELLing Pn. 599-1786

Address 1201 Woodlawn Ave

for office use only

WORK INFORMATION

Sanitary Sewer Tap  <sup>cleanout</sup> Size of Tap \_\_\_\_\_ Size and Type of Sewer \_\_\_\_\_ Street to be Opened \_\_\_\_\_  
yes no

Storm Sewer Tap \_\_\_\_\_ Size of Tap \_\_\_\_\_ Size and Type of Sewer \_\_\_\_\_ Street to be Opened \_\_\_\_\_  
yes no

Street opening Agreement Approval Date \_\_\_\_\_ Opening Bond Fee (Set by Engineer) \_\_\_\_\_  
yes no

READ AND SIGN BELOW; The undersigned hereby agrees complete the work described above and to make use of said sewers only as allowed by and in strict accordance with all applicable provisions of The Napoleon Engineering Dept. Rules and Regulations, The Napoleon Standard Specification for Water Main, Sanitary Sewer and Storm Sewer Construction and other Pertinent Sections of the Napoleon Code of Ordinances.

Date 1-14-91 Signature of Applicant \_\_\_\_\_

Permit not valid without signature

INSPECTION RECORD

to be completed by the Field Inspector

Date Inspection is made 1/14/91 Size and Type of Sewer 6" P.V.C.

Location \_\_\_\_\_ Depth 7 FT Type of Test \_\_\_\_\_ Additional Information \_\_\_\_\_

4 L.F. Pipe installed w/cleanout


Date 1/14/91 Inspected By Malcolm Helberg

signature of inspector

Sketch Of Installation on Back or Attached

Attached

1-14-91 Contractor Bill ELLING  
Jerry GLANZ

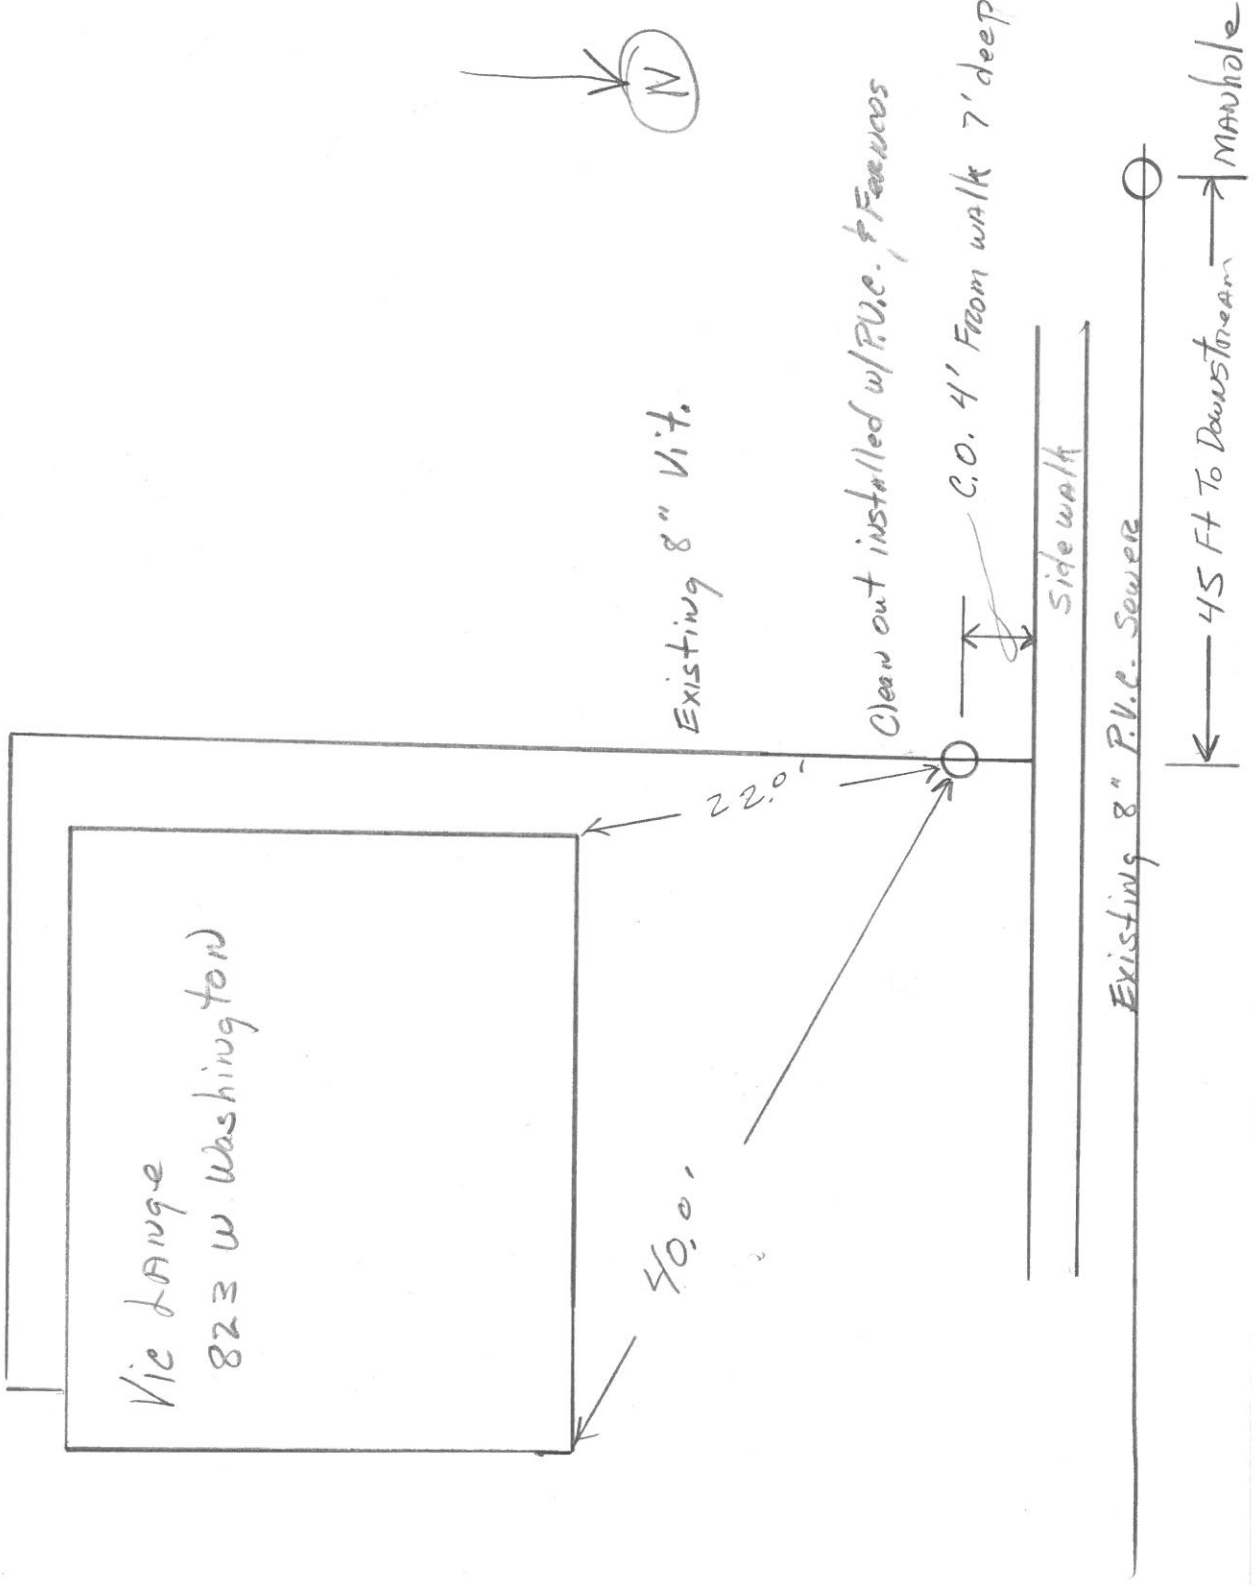

Name VICTOR LANGE Size of Tap \_\_\_\_\_ Date 3 NOV 70

Street 823 W WASHINGTON Size and Kind of Sewer 6" VCP


Old No. \_\_\_\_\_ Location of Sewer \_\_\_\_\_

New No. \_\_\_\_\_ Depth of Sewer \_\_\_\_\_

Crossover 6" VCP Distance to Curb Stop \_\_\_\_\_

Remarks \_\_\_\_\_

*Original Tap*

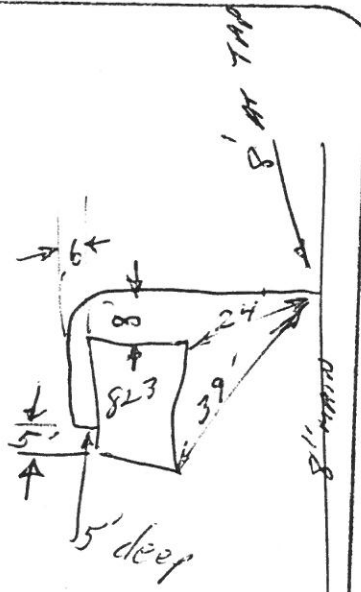

*W. WASHINGTON*



*Staff 6*