

SEWER TAPPING PERMIT

Issued by

The City of Napoleon Engineering Dept.

255 West Riverview Ave. Napoleon, Ohio 43545 Pn. 592-4010

Entry No. _____

Permit No. 00420 Issued 4-12-93 Build. Permit No. _____

Job Location 619 Wayne

Lot _____

Issued By _____ sub div. or legal disc.

Owner _____ Pn. _____

Address _____

Agent _____ Pn. _____

Address _____

Permit Fee \$ 60.00

Street Bond \$ 500.00

Date Paid 4-12-93

for office use only

WORK INFORMATION

Sanitary Sewer Tap _____ Size of Tap _____ Size and Type of Sewer _____ Street to be Opened _____
yes no

Storm Sewer Tap _____ Size of Tap _____ Size and Type of Sewer _____ Street to be Opened _____
yes no

Street opening Agreement Approval Date _____ Opening Bond Fee (Set by Engineer) _____
yes no

READ AND SIGN BELOW; The undersigned hereby agrees complete the work described above and to make use of said sewers only as allowed by and in strict accordance with all applicable provisions of The Napoleon Engineering Dept. Rules and Regulations, The Napoleon Standard Specification for Water Main, Sanitary Sewer and Storm Sewer Construction and other Pertinent Sections of the Napoleon Code of Ordinances.

Date _____ Signature of Applicant Michael L. Christman

Permit not valid without signature

INSPECTION RECORD _____ to be completed by the Field Inspector

Date Inspection is made _____ Size and Type of Sewer _____


Location _____ Depth _____ Type of Test _____ Additional Information _____

Date _____ Inspected By _____


signature of inspector

Sketch Of Installation on Back or Attached


4-14-93 Mike Bastermiller

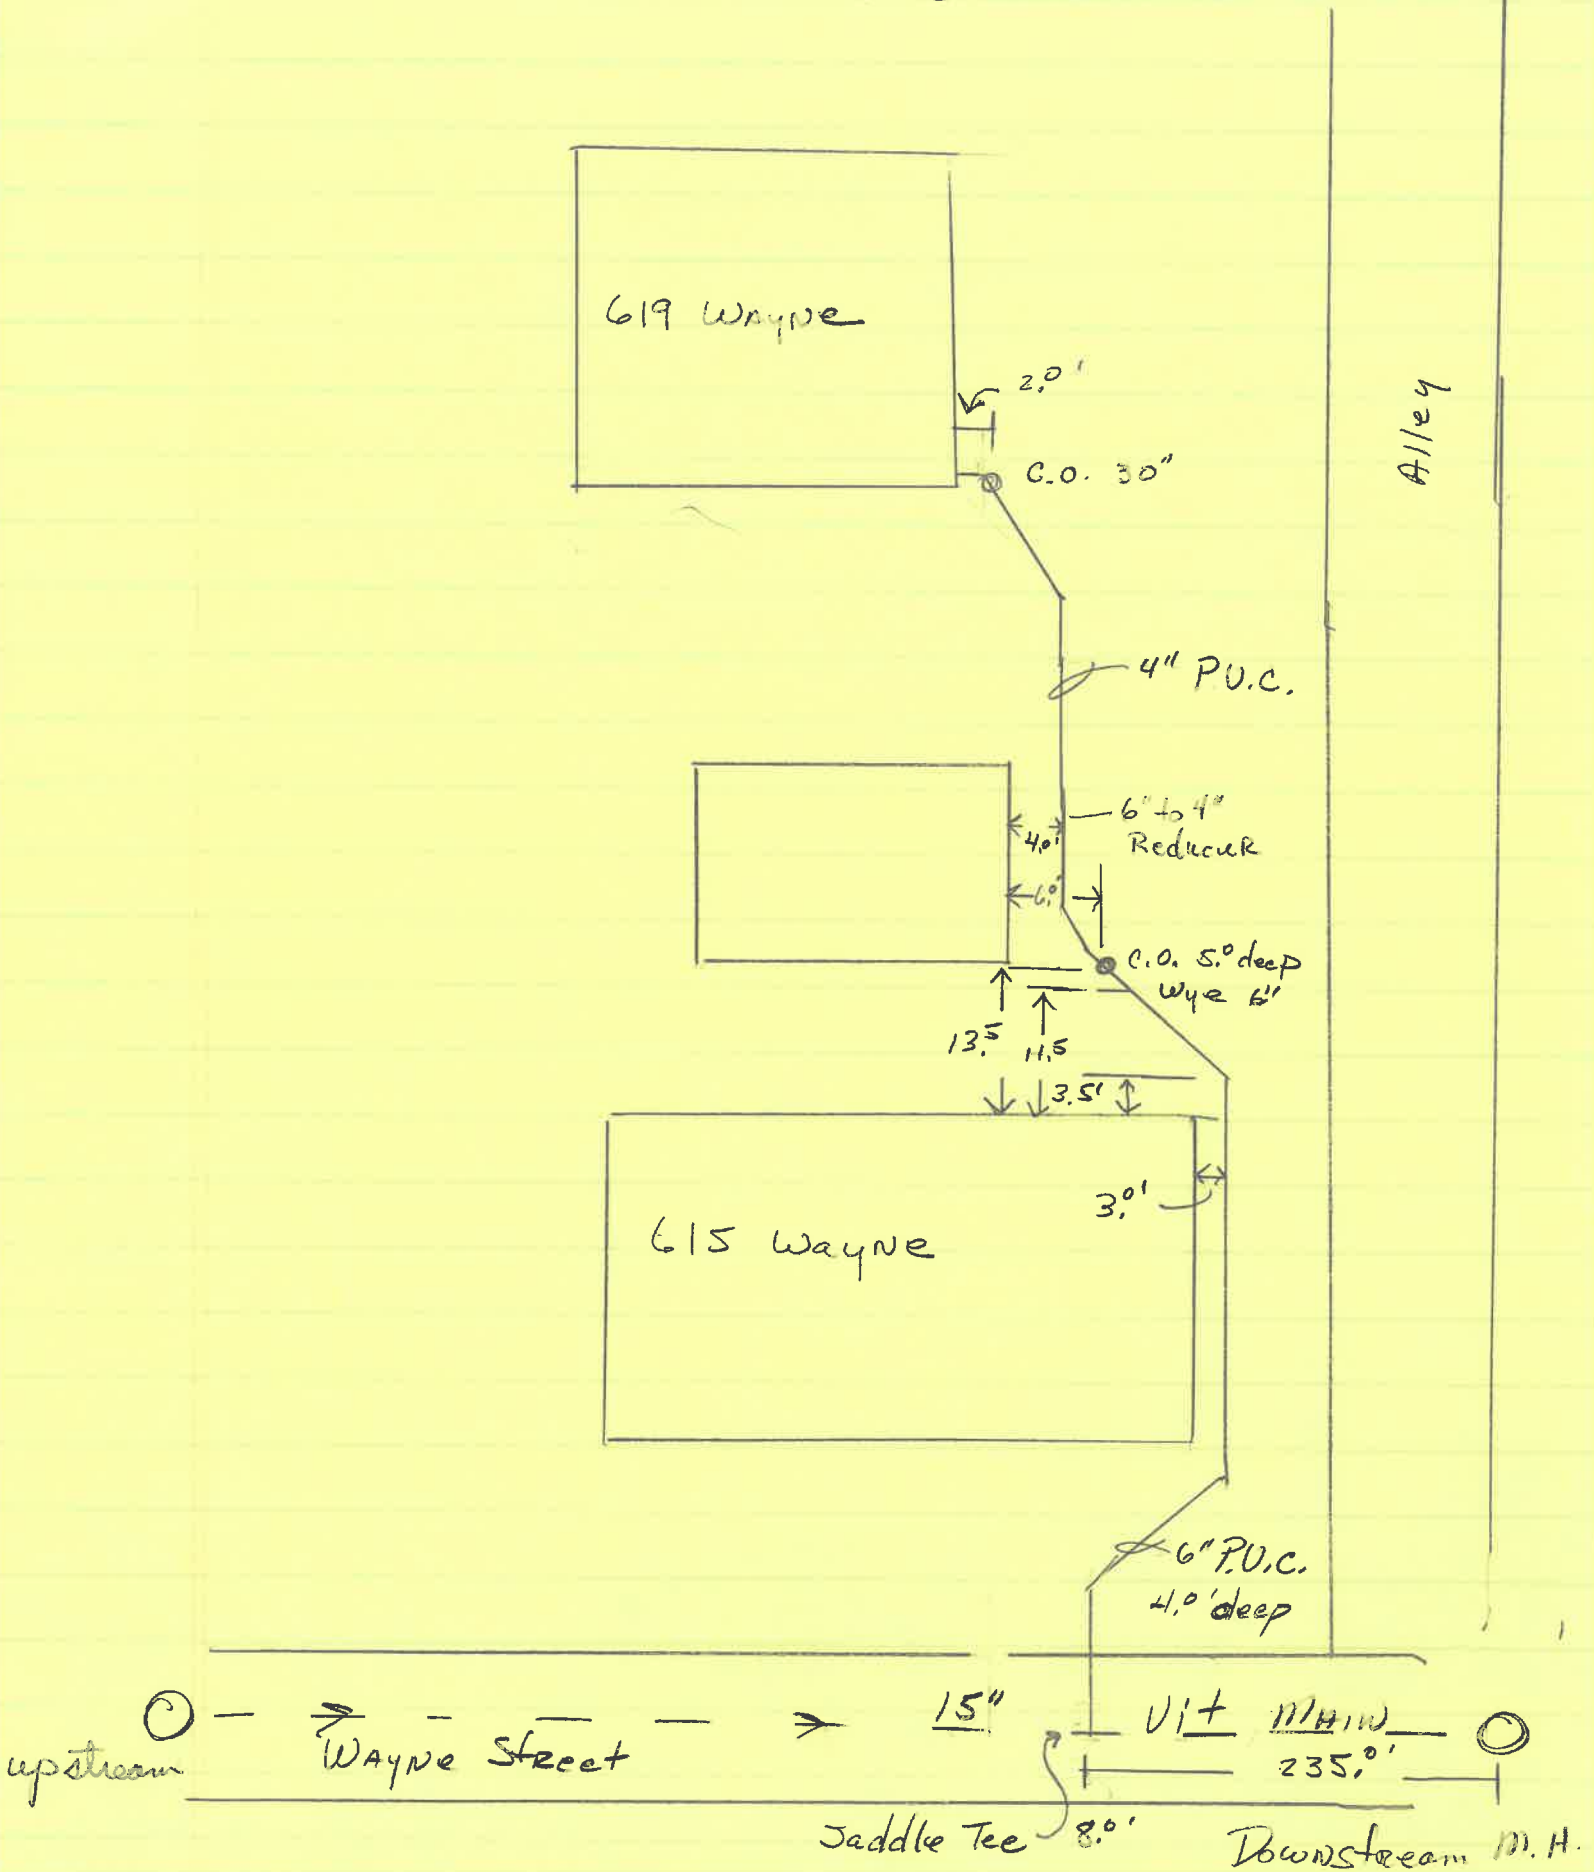

4-14-93 Mike Custer Miller

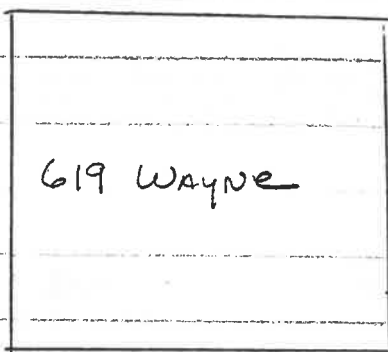

Alley

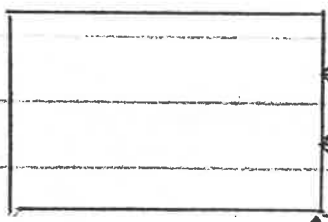


4" P.U.C.

C.O. 5.0' deep Wye 6'

13.5' H.S.

3.5'

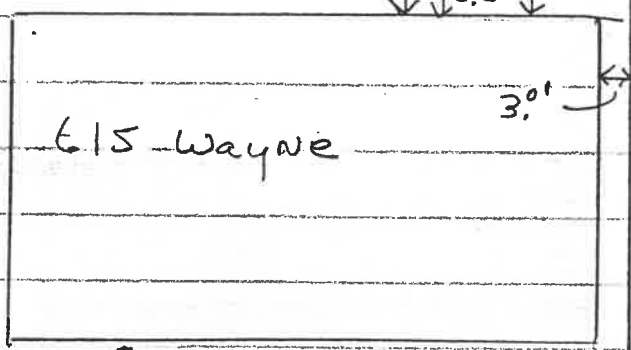

6" P.U.C.
4.0' deep

