

PERMIT
 CITY OF NAPOLEON, OHIO - BUILDING DEPARTMENT
 255 West Riverview Avenue, Napoleon, Ohio 43545 - (419) 592-4010

Permit No. 3274 Issued 07/14/94

Job Location 1096 Westchester

Lot _____

Issued by Robert C. Jones

Owner Jimmie Bialecki 592-2486

Address 1096 Westchester Napoleon, OH

Agent Dennis E. Damman

Address R-475 Rd. 13A Rt. #6
Napoleon, OH

Use Type - Residential X

Other - Describe _____

No. Dwelling Units _____

New _____ Replacement _____

Add'n. X Alter _____ Remodel _____

Mixed Occupancy _____

Change of Occupancy _____

Estimated Cost \$ 9,396.00

FEES	BASE	PLUS	TOTAL
<input checked="" type="checkbox"/> Building	\$ 9.00	\$ 46.00	\$ 55.00
<input type="checkbox"/> Electrical	\$	\$	\$
<input type="checkbox"/> Plumbing	\$	\$	\$
<input type="checkbox"/> Mechanical	\$	\$	\$
<input type="checkbox"/> Demolition	\$	\$	\$
<input type="checkbox"/> Zoning	\$	\$	\$
<input type="checkbox"/> Sign	\$	\$	\$
<input type="checkbox"/> Water Tap	\$	\$	\$
<input type="checkbox"/> Sew. Insp.	\$	\$	\$
<input type="checkbox"/> Sewer Tap	\$	\$	\$
<input type="checkbox"/> Temp. Water	\$	\$	\$
<input type="checkbox"/> Temp. Elec.	\$	\$	\$
TOTAL FEES.....			\$ 55.00
LESS FEES PAID.....			\$
BALANCE DUE.....			\$

ZONING INFORMATION

district	lot dimensions		area	front yd	side yd	rear yd
max hgt	no pkg spaces	no ldg spaces	max cover	petition or appeal req'd	date appr	

WORK INFORMATION

Size: Length _____ Width _____ Stories _____ Ground Floor Area _____

Height _____ Building Volume (for Demo. Permit) _____


Electrical: _____


Plumbing: _____

Mechanical: _____

Additional Information: Add covered patio & vinyl siding on upper story

Date 7-14-94 Applicant Signature Dennis E. Damman

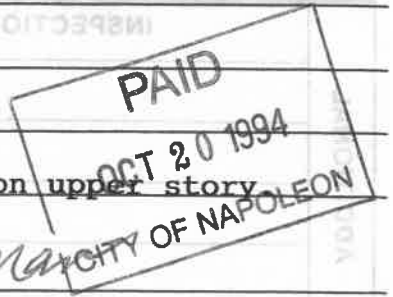


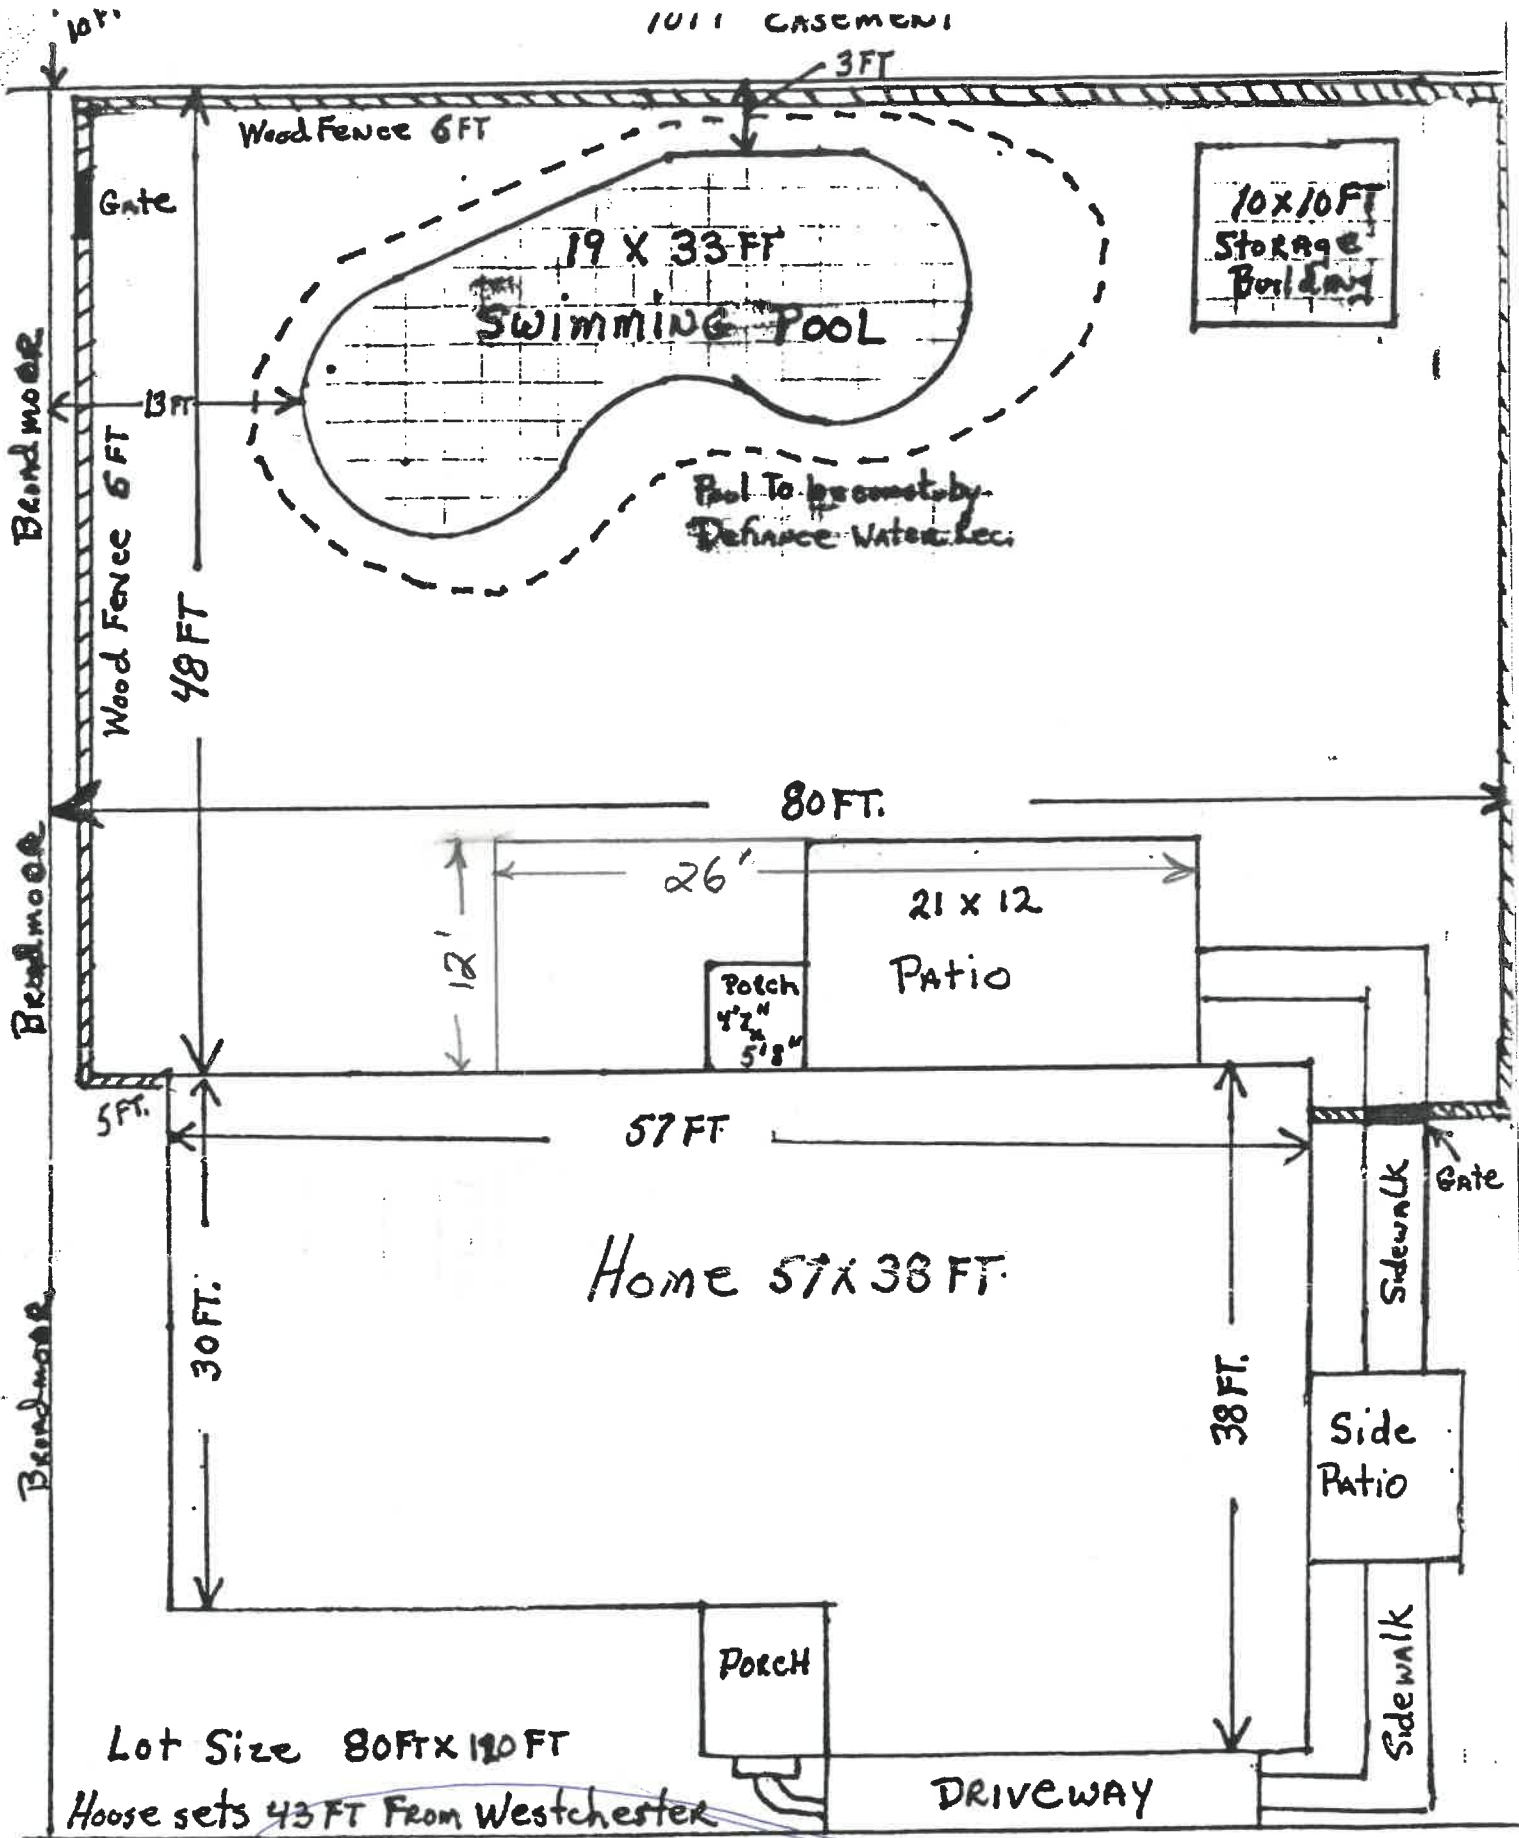

1096 Westchester

NAPOLEON BUILDING DEPARTMENT (SAMPLE DRAWING)

1096 Westchester

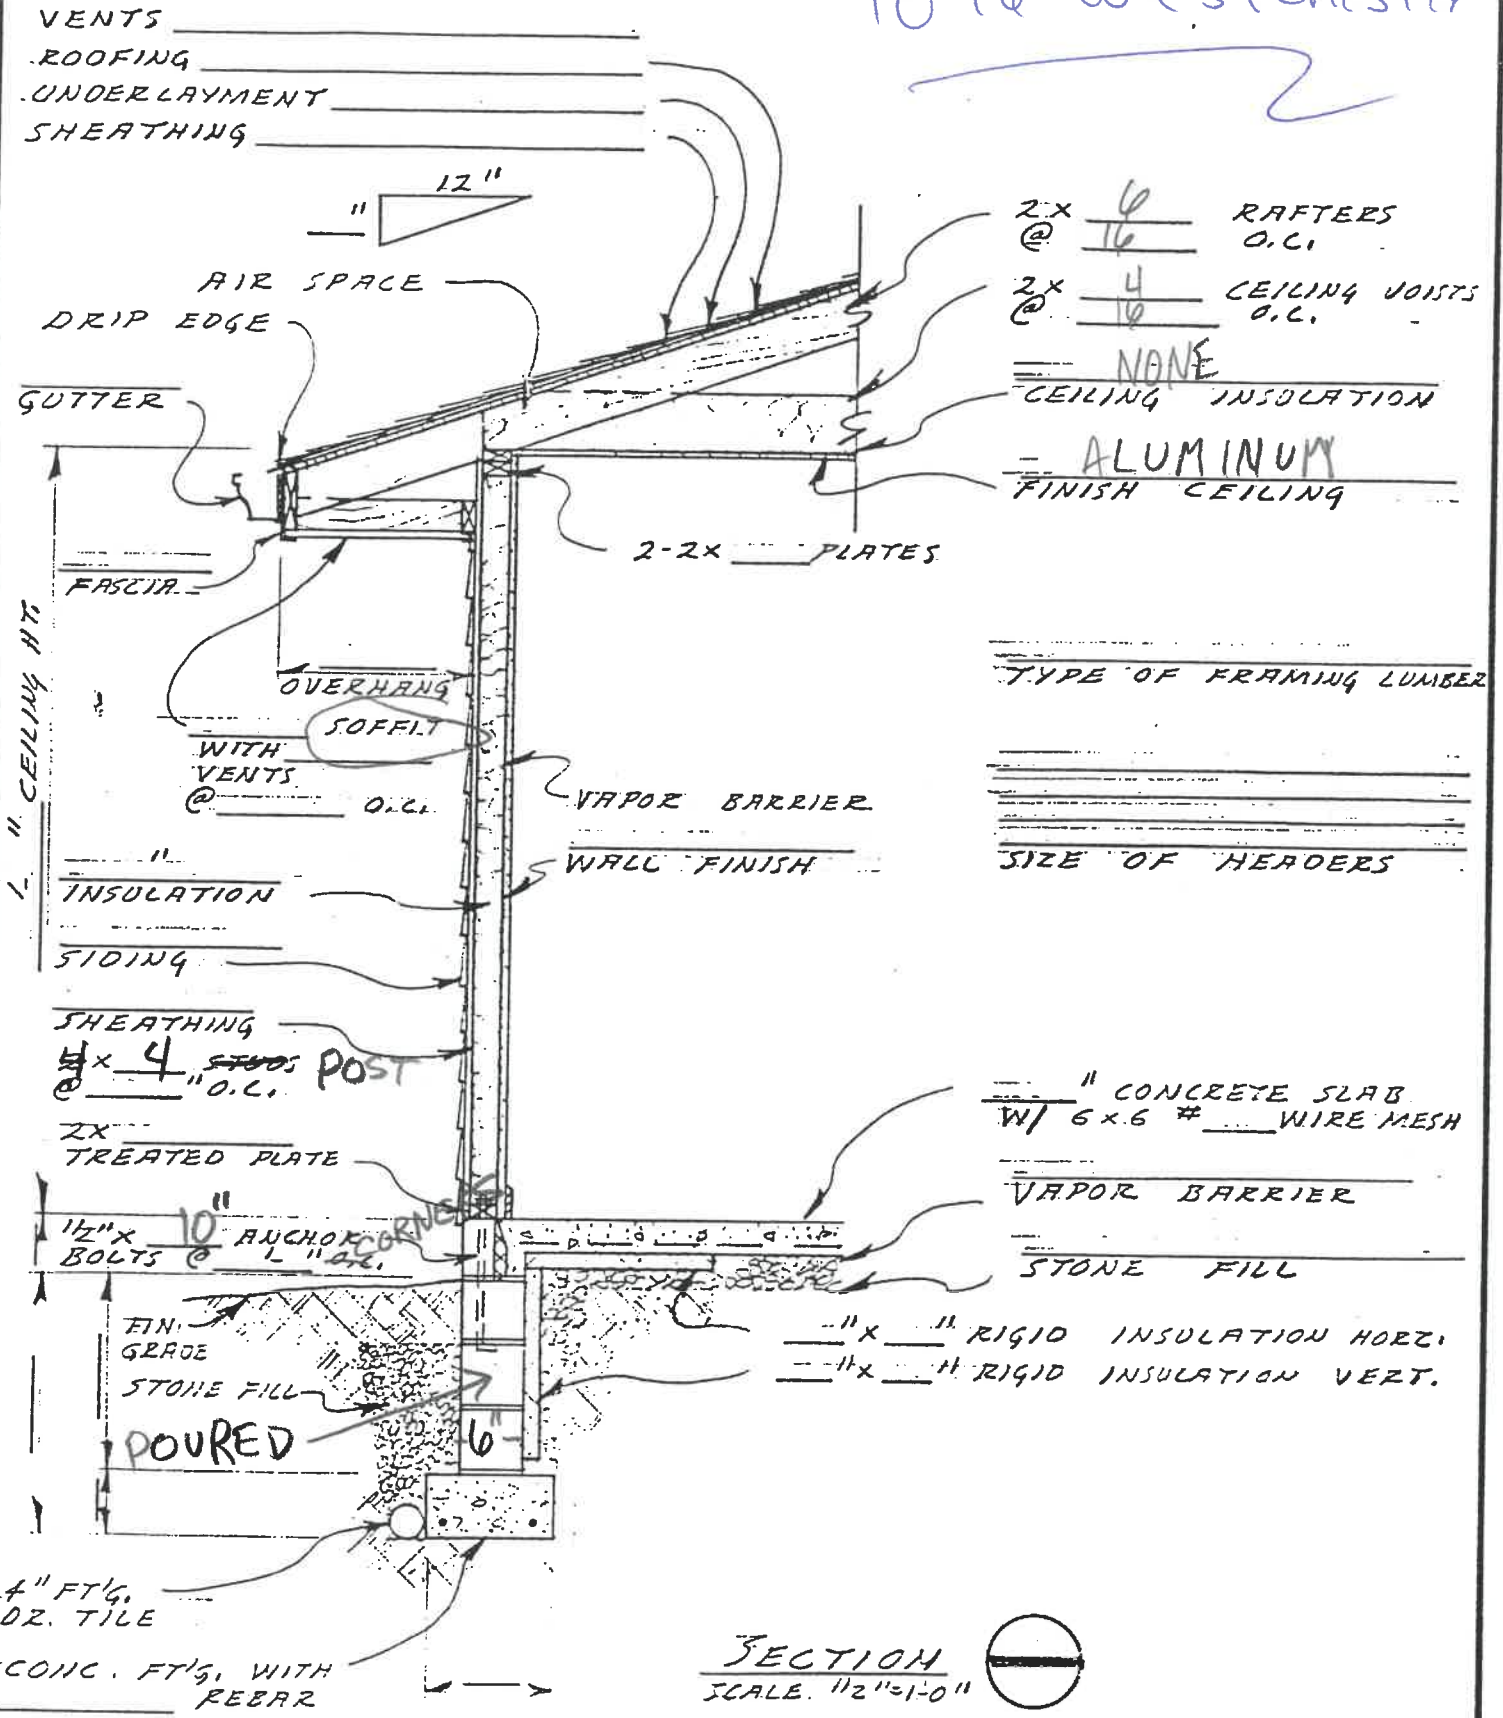

DATE	WALL SECTION @ SLAB ON GRADE	DWG. NO OF
------	------------------------------	------------

4-11-57 E/H

APPLICATION FOR

Residential, Building, Electrical, Plumbing, Mechanical, and Demolition Permit

FROM - The City of Napoleon, Ohio, Building Department

255 West Riverview Avenue; P.O. Box 151; Napoleon, Ohio 43545 - Telephone (419) 592-4010

ENTRY NO. _____

PERMIT NO. 3274 ISSUED 7-14-90 () Building \$ 9.00 \$ 46.00 \$ 55.00

JOB LOCATION 1096 WESTCHESTER () Electrical \$ _____ \$ _____ \$ _____

LOT _____ () Plumbing \$ _____ \$ _____ \$ _____
(Subdivision or Legal Description)

ISSUED BY RCJ () Mechanical \$ _____ \$ _____ \$ _____
(Building Official) () Demolition \$ _____ \$ _____ \$ _____

OWNER LIMMIE BIALECKI PHONE 592-2486 () Zoning \$ _____ \$ _____ \$ _____

ADDRESS 1096 WESTCHESTER () Sign \$ _____ \$ _____ \$ _____

AGENT DENNIS E. DAMMAN PHONE _____ () Water Tap \$ _____ \$ _____ \$ _____

ADDRESS R-475 RD/3A-R-6 () Sewer Tap \$ _____ \$ _____ \$ _____

USE: (X) Residential () Commercial () Industrial () Temp Water \$ _____ \$ _____ \$ _____
() Other _____ () Temp Elec. \$ _____ \$ _____ \$ _____

WORK: () New (X) Addition () Replacement () Remodel

ESTIMATED COST = \$ 9396.00

Additional Structure _____ Hours _____
Plan Review: Electric _____ Hours _____

TOTAL FEES	\$ <u>55.00</u>
Less Fees Paid	\$ _____
BALANCE DUE	\$ _____

ZONING INFORMATION

District	Lot Dimensions	Area	Front Yard	Side Yard	Rear Yard

Max Height	No. Pkg. Spaces	No. Ldg. Spaces	Max Cover	Petition or Appeal Required-Date

WORK INFORMATION


Building: Ground Floor Area _____ sq. ft. Basement Floor Area _____ sq. ft.

Garage Floor Area _____ sq. ft. 2nd Floor Area _____ sq. ft. Other _____ sq. ft.

Size: Width _____ Length _____ Stories _____ Height _____

Building Volume (for Demolition Permit) _____ cubic feet

Description of Work: ADD COVERED PATIO & VINYL SIDING ON

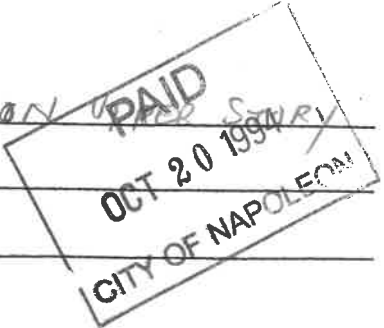

ELECTRICAL: Contractor _____ Phone _____

Address _____ ESTIMATED COST = \$ _____

Type of Work: () New () Service Change () Rewiring () Add'l Wiring TEMPORARY ELEC. REQUIRED - () Yes () No

Size of Service _____ Underground _____ Overhead _____ Number of New Circuits _____

Description of Work: _____

PLUMBING: Contractor _____ Phone _____

Address _____ ESTIMATED COST = \$ _____

WATER TAP REQUIRED -- () Yes () No Size _____ Type of Pipe _____ Water Dist. Pipe _____

SANITARY SEWER TAP REQUIRED - () Yes () No Size _____ Type of Pipe _____ Dr. Waste Vt. Pipe _____

STREET SEWER TAP REQUIRED - () Yes () No Type of Pipe _____ STREET TO BE OPENED - () Yes () No

Main Building Drain Size = _____ Main Vent Pipe Size = _____

LIST NUMBER OF PLUMBING FIXTURES BELOW:

Water Closets = _____ Bathtubs = _____ Showers = _____ Lavatories = _____ Kitchen Sinks = _____ Disposal = _____

Clothes Washer = _____ Floor Drains = _____ Dishwasher = _____ Other _____ Total = _____

Description of Work: _____

MECHANICAL: Contractor _____ Phone _____

Address _____ ESTIMATED COST = \$ _____

HEATING SYSTEM - () Forced Air () Gravity () Hot Water () Steam () Unit Heaters () Radiant () Baseboard

TYPE OF FUEL - () Electric () Natural Gas () Propane () Wood () Coal () Solar () Geothermal Other _____

NUMBER OF HEAT ZONES = _____ HOT WATER - () One (1) Pipe () Two (2) Pipes () Series Loop

ELECTRIC HEAT - Number of Circuits _____ Number of Furnaces _____ Number of Hot Air Runs _____

Number of Hot Water Radiators _____ Total Heat Loss _____ Rated Capacity of Furnace/Boiler _____

LOCATION OF HEATING UNITS - () Crawl Space () Floor Level () Attic () Suspended () Roof () Outside

Description of Work: _____

DRAWINGS REQUIRED: All applications must be accompanied by two (2) complete sets of Drawings including Site Plans, Foundation Plans, Floor Plans, Structural Framing Plans, Exterior Elevations, Section and Details, Stair Details, Electrical Layout, Plumbing Isometric, Heating Layout, etc. All Plans shall be drawn to scale, show all existing structure on the Site Plans, and show electric panel and furnace locations.

READ AND SIGN BELOW: The undersigned hereby makes application for a Permit for all work described herein and agrees to complete the work in strict accordance with all applicable provisions of the current edition of the C.A.B.O. Building Code, the Napoleon Building and Zoning Codes, the Napoleon Engineering Department Rules and Regulations, Standard Specifications and other pertinent sections of the Napoleon Code of Ordinances.

Signature of Applicant _____ Date _____