

SEWER TAPPING PERMIT

Issued by

The City of Napoleon Engineering Dept.

255 West Riverview Ave. Napoleon, Ohio 43545 Pn. 592-4010

Entry No. _____

Permit No. SA0143 Issued 6-25-90 Build. Permit No. _____

Permit Fee \$ 60.00

Job Location 920 WEST MONT

Street Bond \$ _____

Lot 47 Spangler Addition

Date Paid 6-25-90

Issued By [Signature] sub div. or legal disc.

Owner VIRGIL DAGEN Pn. _____

Address RR# 2 Napoleon, Ohio

Agent MOEL CORDES PUG Pn. 758-3855

Address RR# 4 Napoleon, Ohio

for office use only

WORK INFORMATION

Sanitary Sewer Tap _____ Size of Tap L Size and Type of Sewer 4 CO. IN SEWER Street to be Opened X

Storm Sewer Tap _____ Size of Tap _____ Size and Type of Sewer _____ Street to be Opened _____

Street opening Agreement Approval Date _____ Opening Bond Fee (Set by Engineer) _____

READ AND SIGN BELOW; The undersigned hereby agrees complete the work described above and to make use of said sewers only as allowed by and in strict accordance with all applicable provisions of The Napoleon Engineering Dept. Rules and Regulations, The Napoleon Standard Specification for Water Main, Sanitary Sewer and Storm Sewer Construction and other Pertinent Sections of the Napoleon Code of Ordinances.

Date June 25, 1990 Signature of Applicant [Signature] Permit not valid without signature

INSPECTION RECORD _____ to be completed by the Field Inspector


Date Inspection is made _____ Size and Type of Sewer _____

Location _____ Depth _____ Type of Test _____ Additional Information _____

Date _____ Inspected By _____ signature of inspector

Sketch Of Installation on Back or Attached

PAID JUN 25 1990 CITY OF NAPOLEON

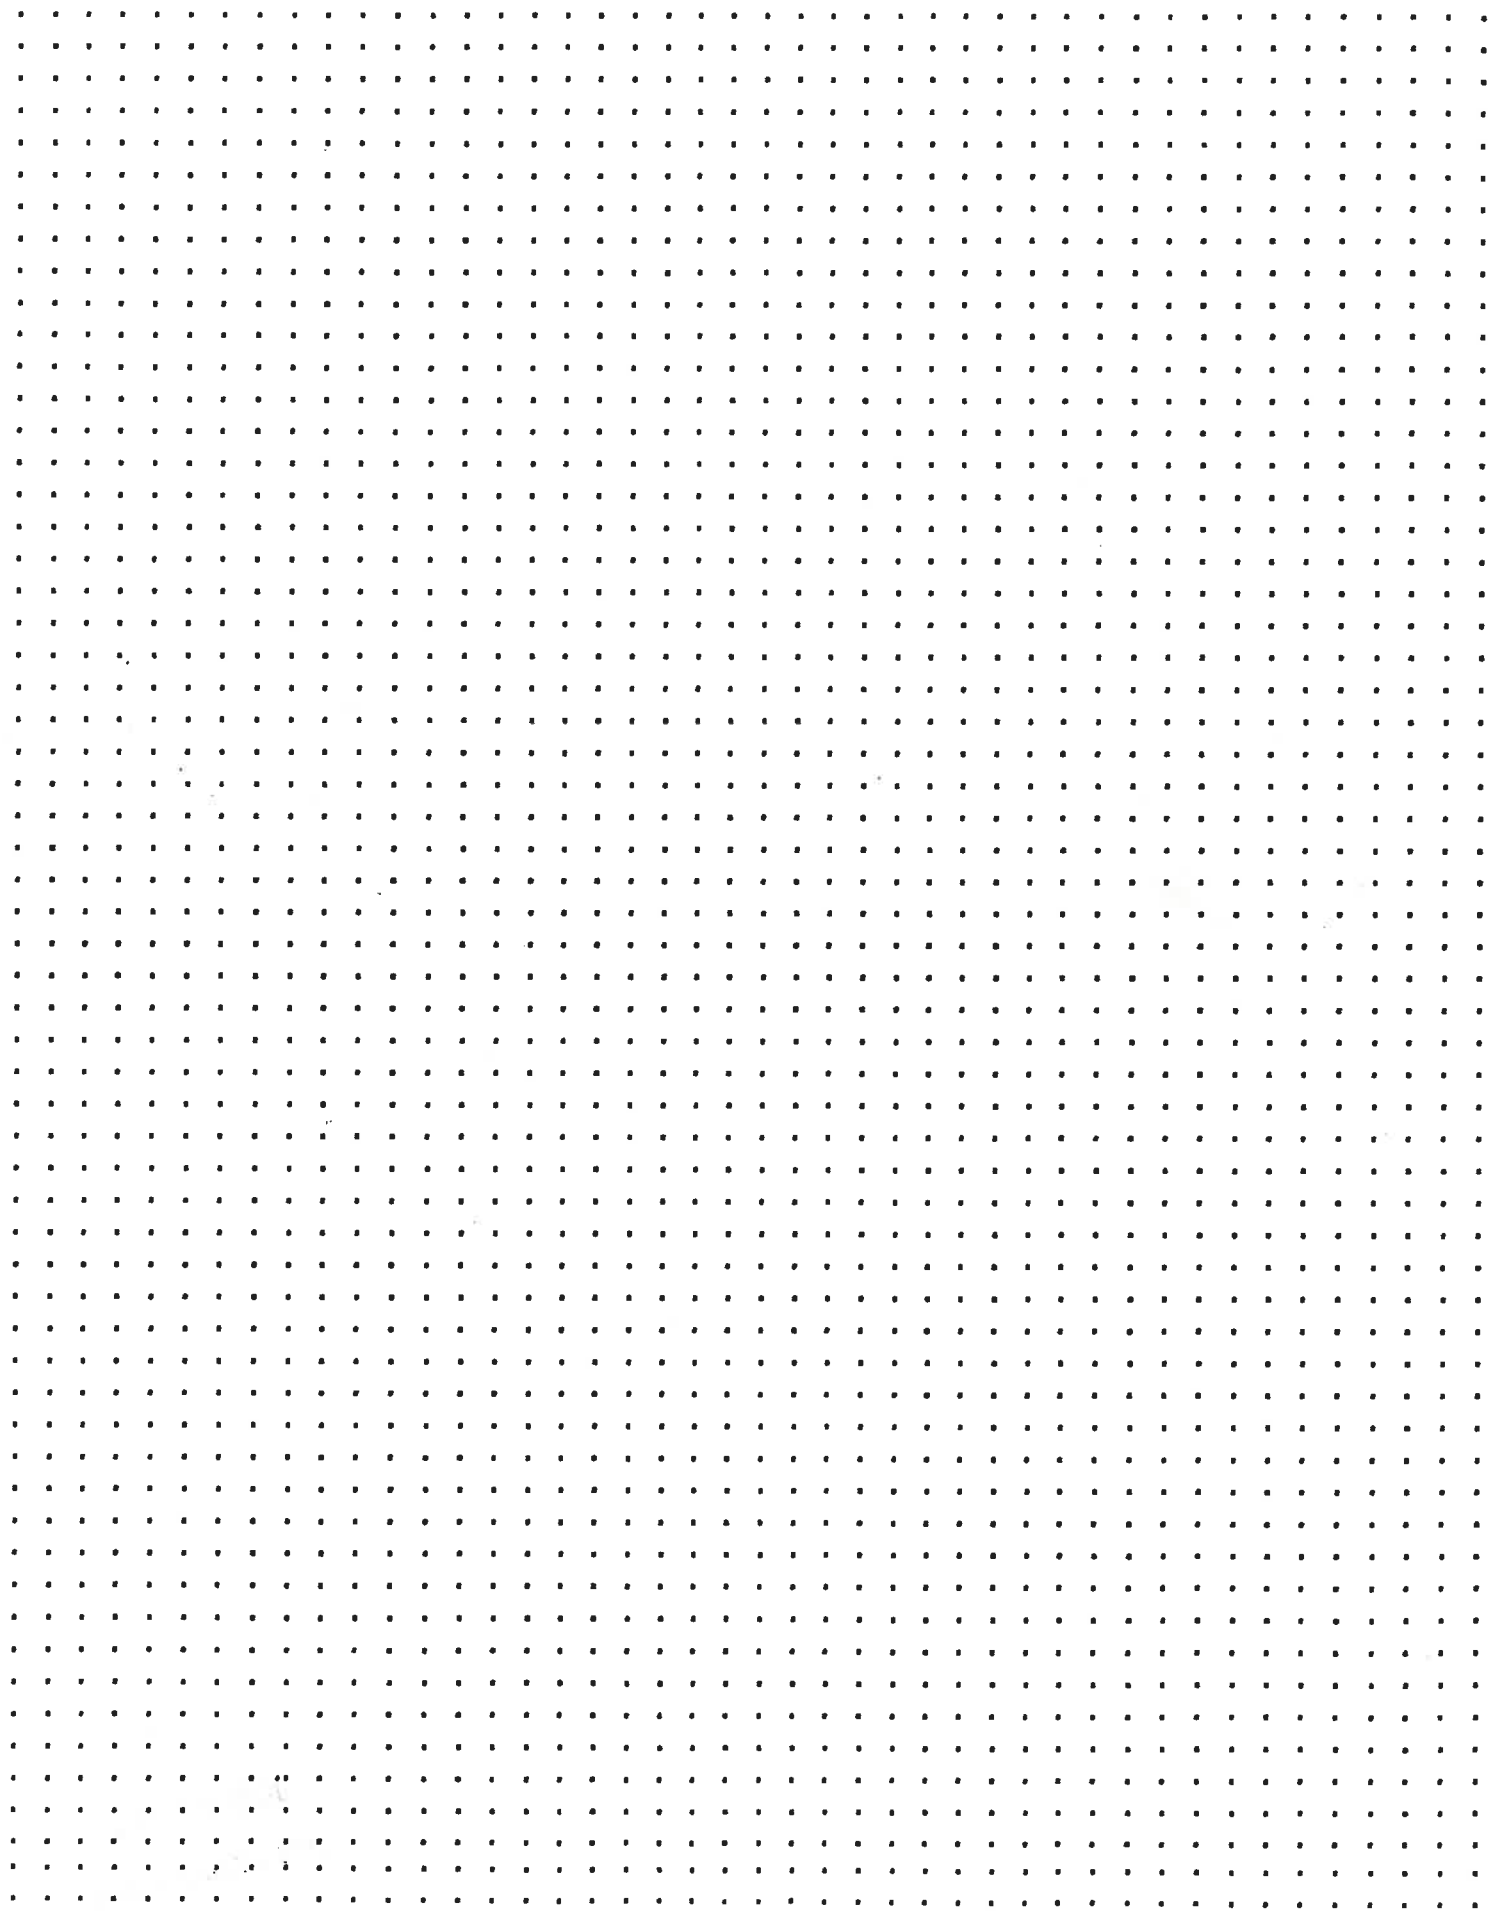


Contractor Mort Carder Edge

6-25-90

Owner Virgel Vajen
970 Westmont

Fence to Cost iron

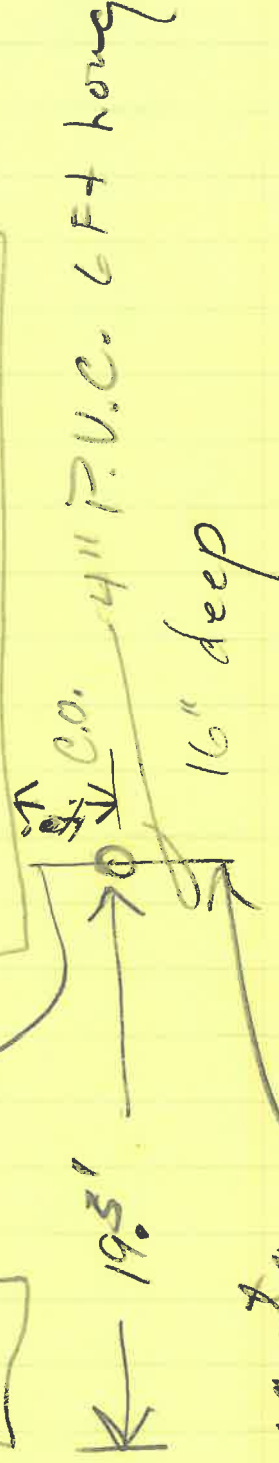

16" deep

Fence to
Vid.

