



BECK'S CONSTRUCTION  
R.R. # 3  
NAPOLEON, OHIO

1760 ~~1000~~ sq. ft. GROSS AREA  
400 sq. ft. GARAGE  
1360 ~~1260~~ sq. ft. NET LIVING AREA

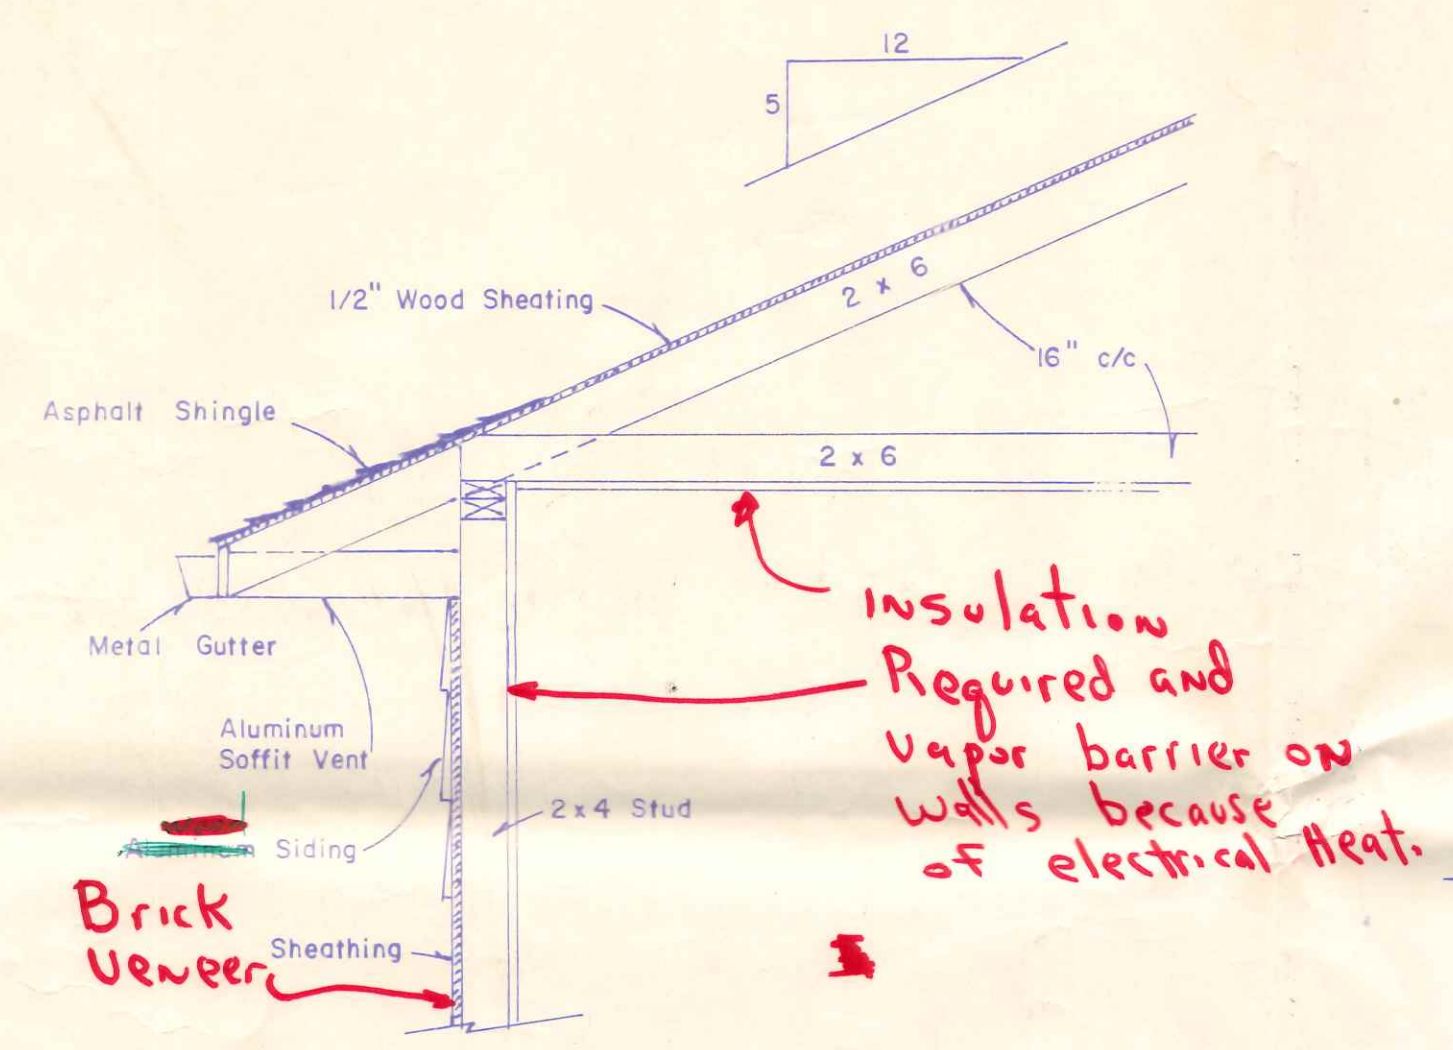


Insulation Required and Vapor barrier on walls because of electrical heat.

Must have approved water resistant sheathing or 15 lb. building paper.

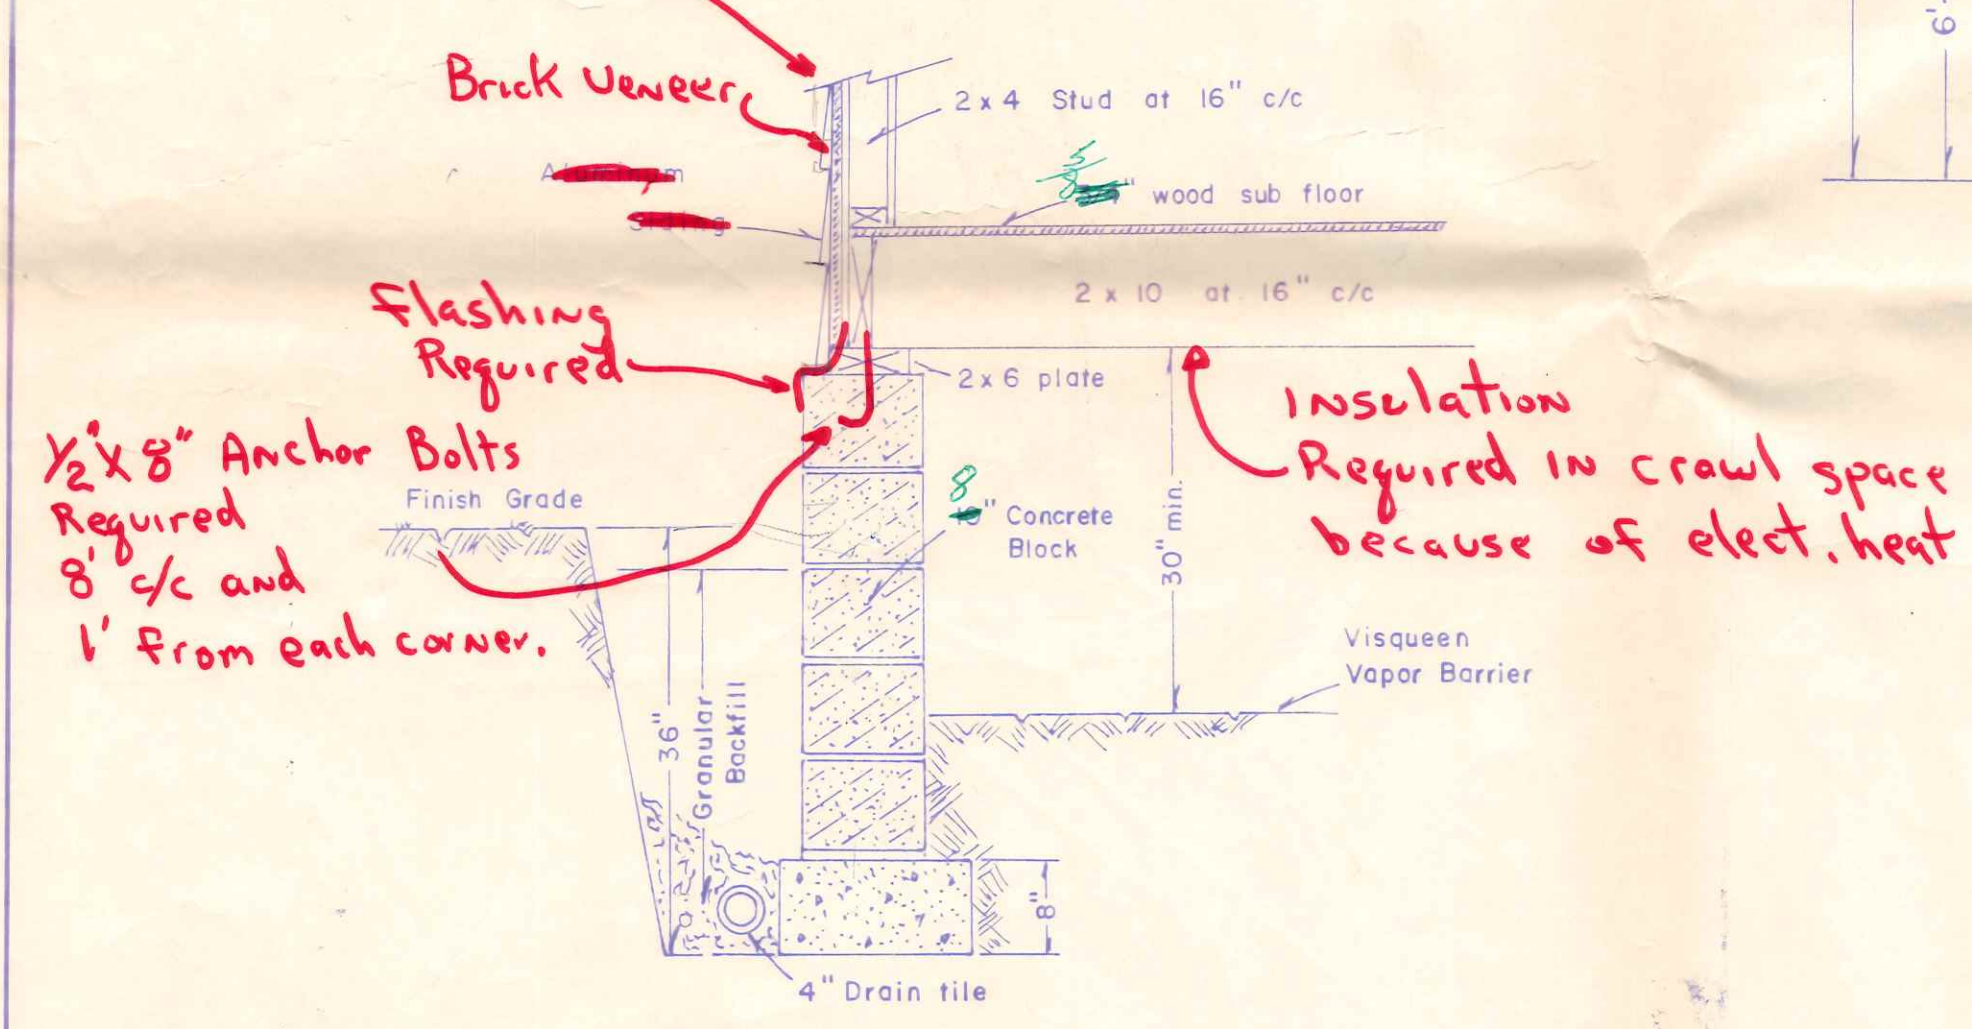

WALL SECTION DETAIL

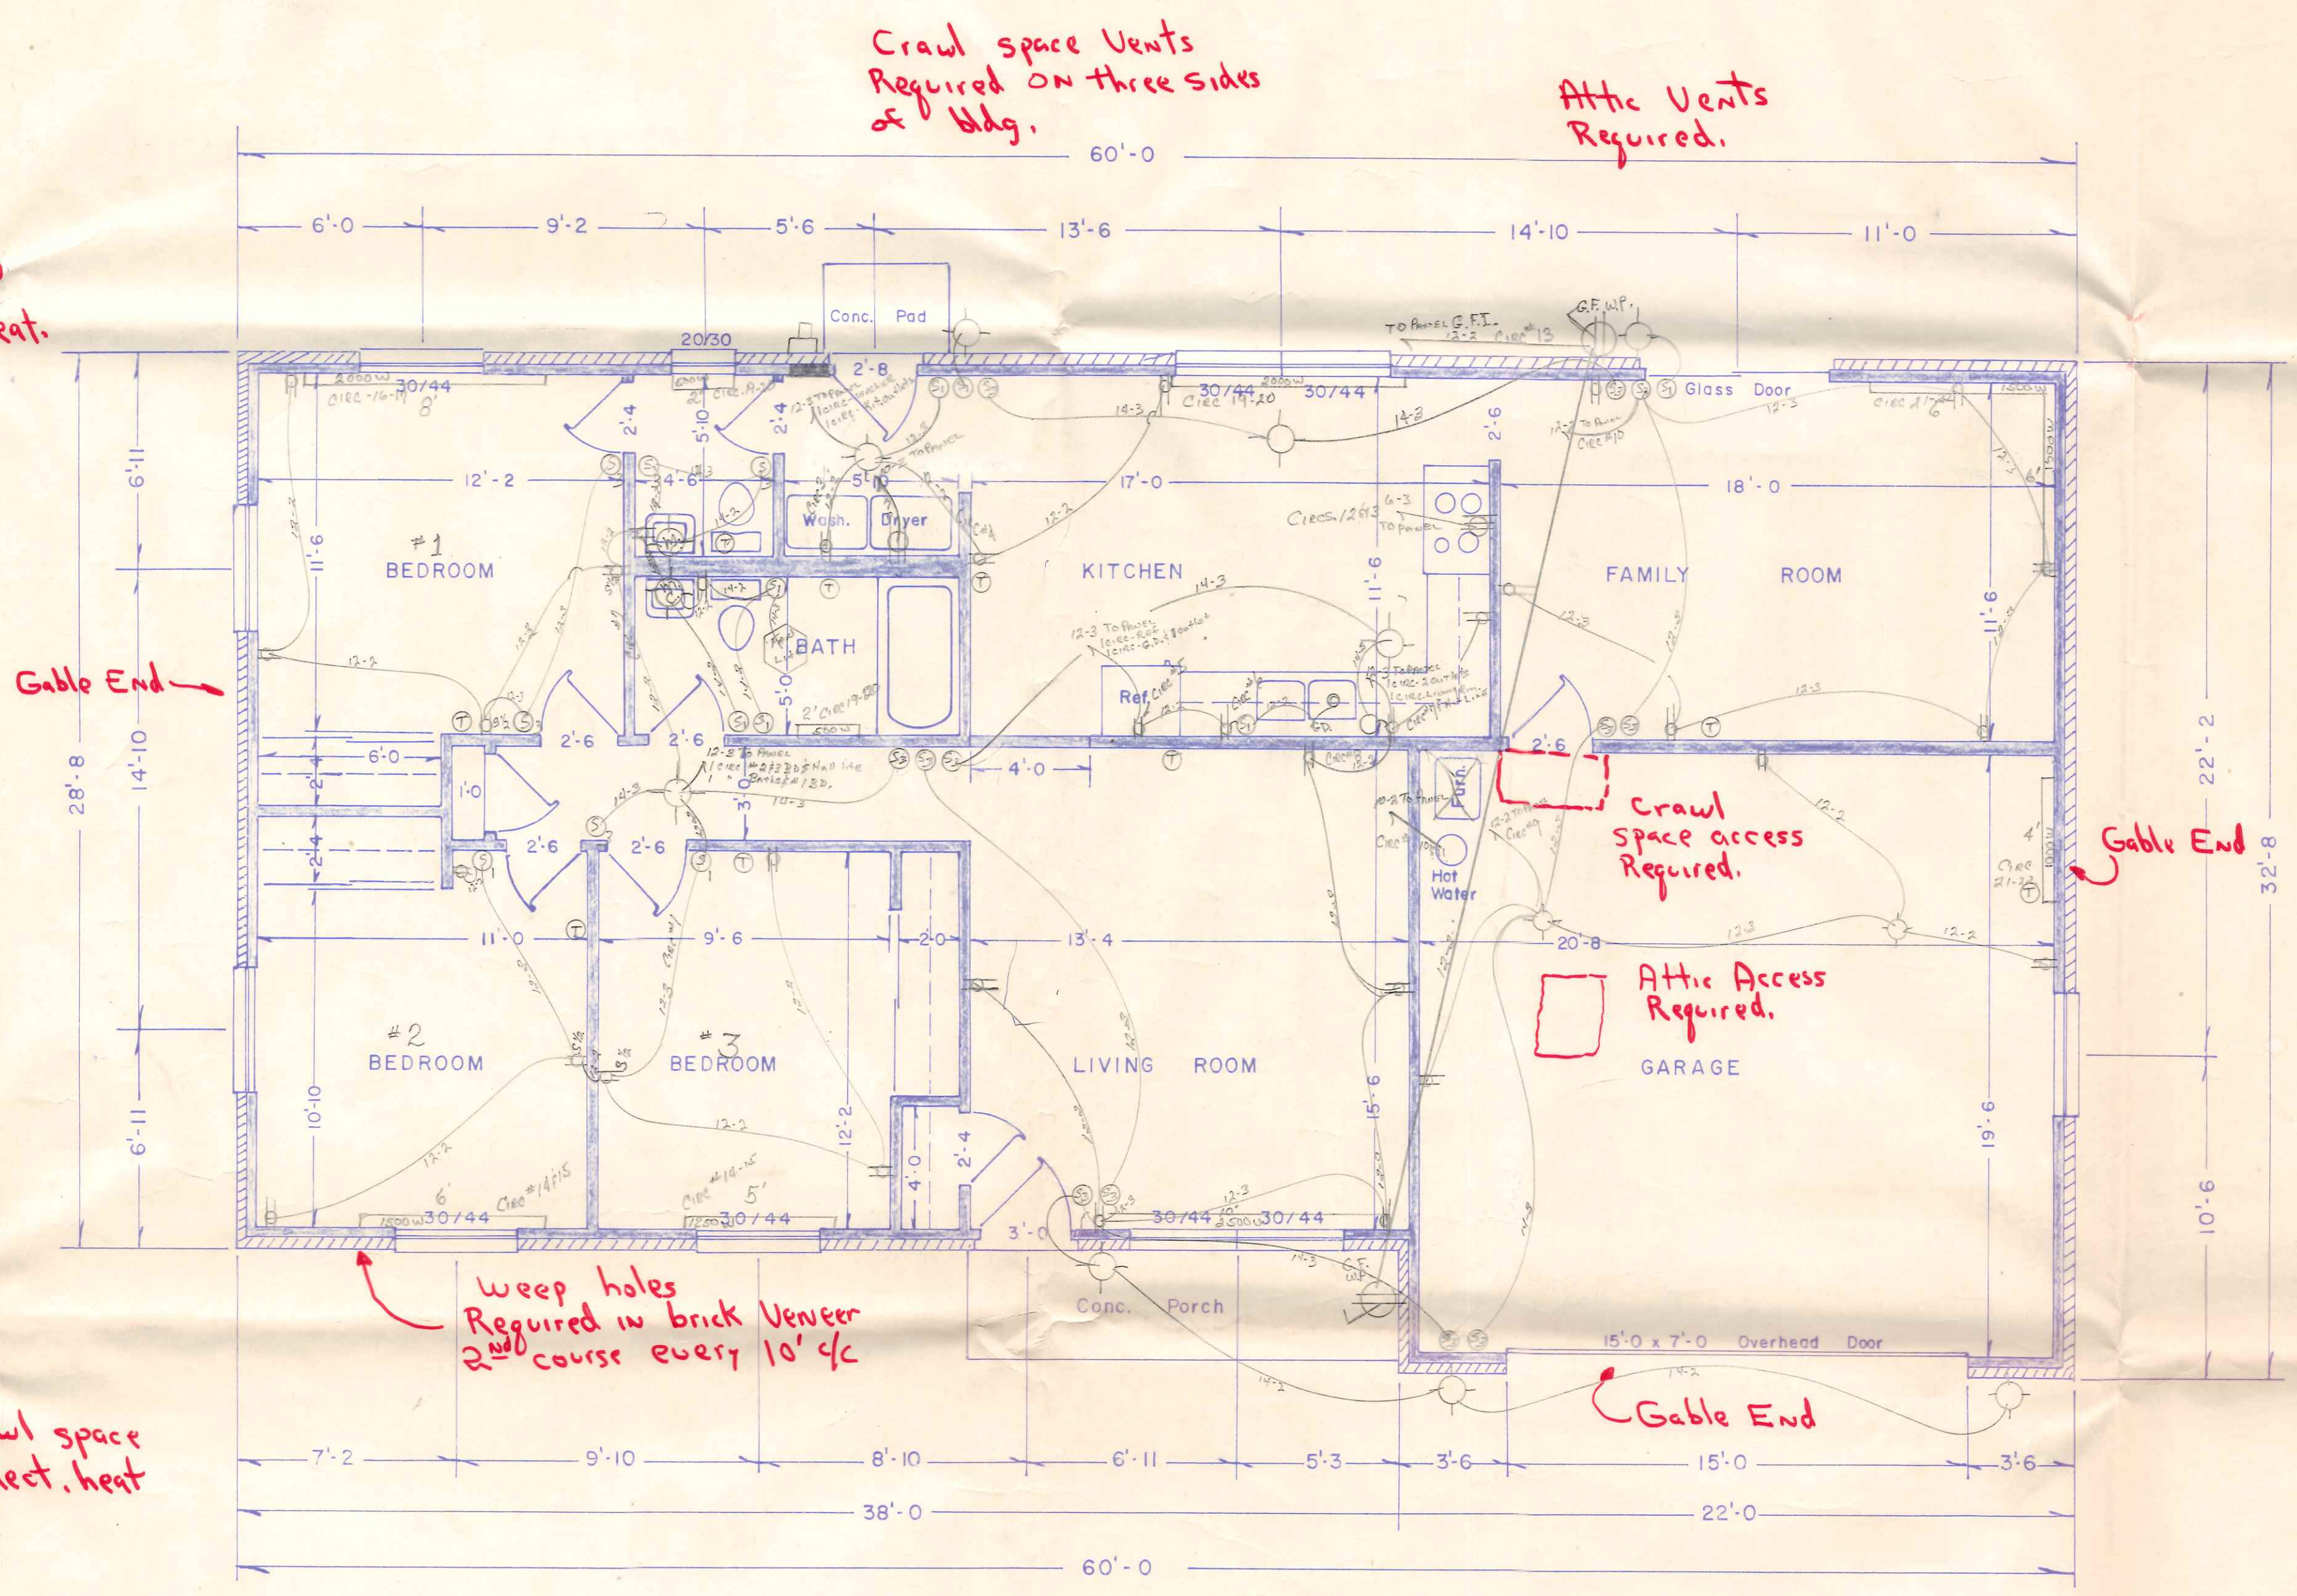

Crawl space Vents Required on three sides of bldg.

Attic Vents Required.

Crawl space access Required.

Attic Access Required.

Weep holes Required in brick Veneer 2nd course every 10' c/c

- NOTE: Exterior finish brick  
 Roof pitch 5" in 12"  
 Roof overhang 2'-8"  
 Rafter & ceiling joist 2" x 6"  
 Floor joist 2" x 10"  
 Subfloor 3/4" plywood  
 3 1/2" - 10" block on 8" x 16" footer


FLOOR PLAN  
Scale: 1/4" = 1'

130 Westwood



Lot 35

94' X 120 Deep

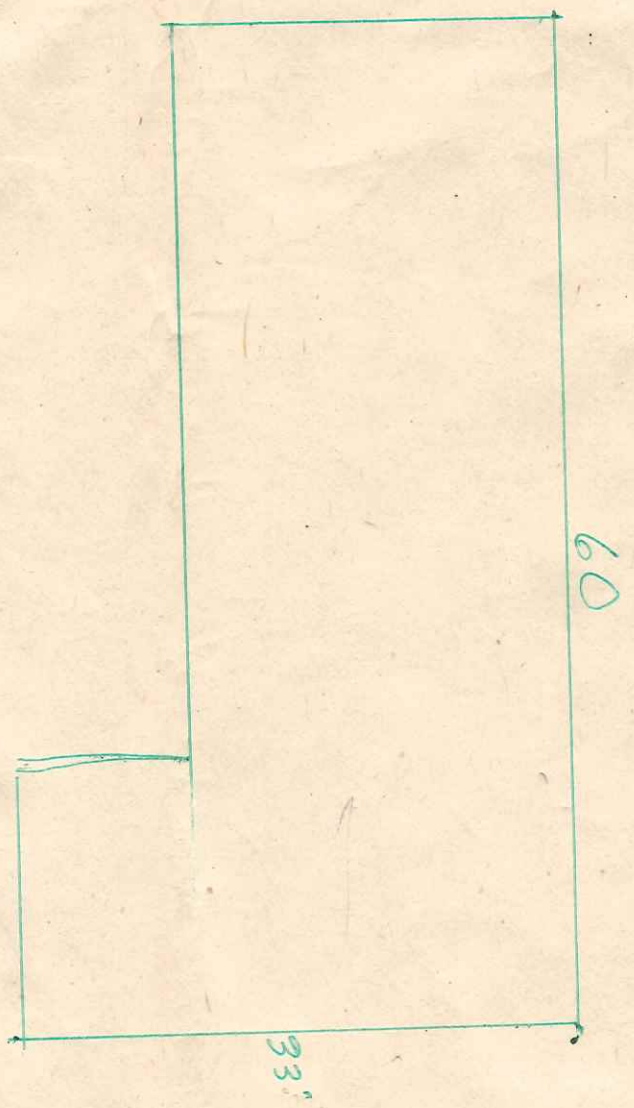

38' set Back  
Westwood  
Harmony Acres