

APPLICATION FOR PERMIT TO TAP SEWER

(Print or Type)

Owner Doane M Ressler NO.
Address 1055 Willard St BLDG. PERMIT
Contractor Bob Cooper PERMIT FEE \$
Address Rt 9 Napdeon Tel. 758-3162 DATE PAID
for office use only

LOCATION OF CONNECTION


Street and No. 1055 Willard Sanitary Storm
Lot No. 7-8 Subdivision Highland Second Division Size of Tap
Size and Type of Sewer ALL WORK MUST BE INSPECTED

I certify that the sewer will be used only as indicated and no other Drainage will be connected.
Date May 31, 1979 Signature Doane E. Ressler owner-builder agent
do not write below this line

INSPECTION RECORD

Date Inspected MAY 31, 1979 Size and Type of Sewer 4" PVC N/A
Location NORTH SIDE FRONT Depth 3' Type of Test N/A
Inspected and Approved By: Bruce Wierand Inspector Date 5/31/79
Additional Information FILLED SEPTIC TANK
RATED Sewer to BASEMENT DRAIN ALREADY HOOKED UP.
Send copy to: DOANE RESSLER 1055 WILLARD

SKETCH OF INSTALLATION

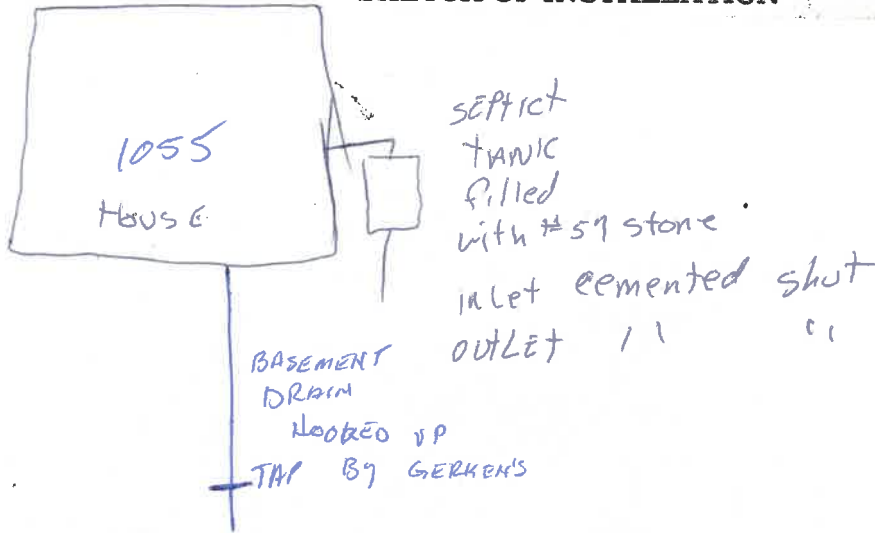

Willard St