

APPLICATION FOR PERMIT TO TAP SEWER

(Print or Type)

Owner Larry J. Durham
Address 1109 Willard St. Dayton Ohio
Contractor Pauls Plumbing Paul W. Stites
Address 164 North St. Tel. 599-2431

NO. _____
BLDG. PERMIT _____
PERMIT FEE \$ _____
DATE PAID _____
for office use only

LOCATION OF CONNECTION

Street and No. 1109 Willard Sanitary Storm _____
Lot No. 11 Subdivision HIGHLAND'S 2ND ADD Size of Tap 6"
Size and Type of Sewer 8" PVC ALL WORK MUST BE INSPECTED

I certify that the sewer will be used only as indicated and no other Drainage will be connected.


Date 6-1-79 Signature Larry J. Durham
owner-builder agent
do not write below this line

INSPECTION RECORD

Date Inspected 6-12-79 Size and Type of Sewer 6" VIT.
Location REAR to ALLEY Depth 4' @ tap 2' @ conn. Type of Test N/A.
Inspected and Approved By: Bruce Weirauch Date 6-12-79
Inspector
Additional Information SEPTIC TANK FILLED WITH SAND

Send copy to: LARRY DURHAM

SKETCH OF INSTALLATION

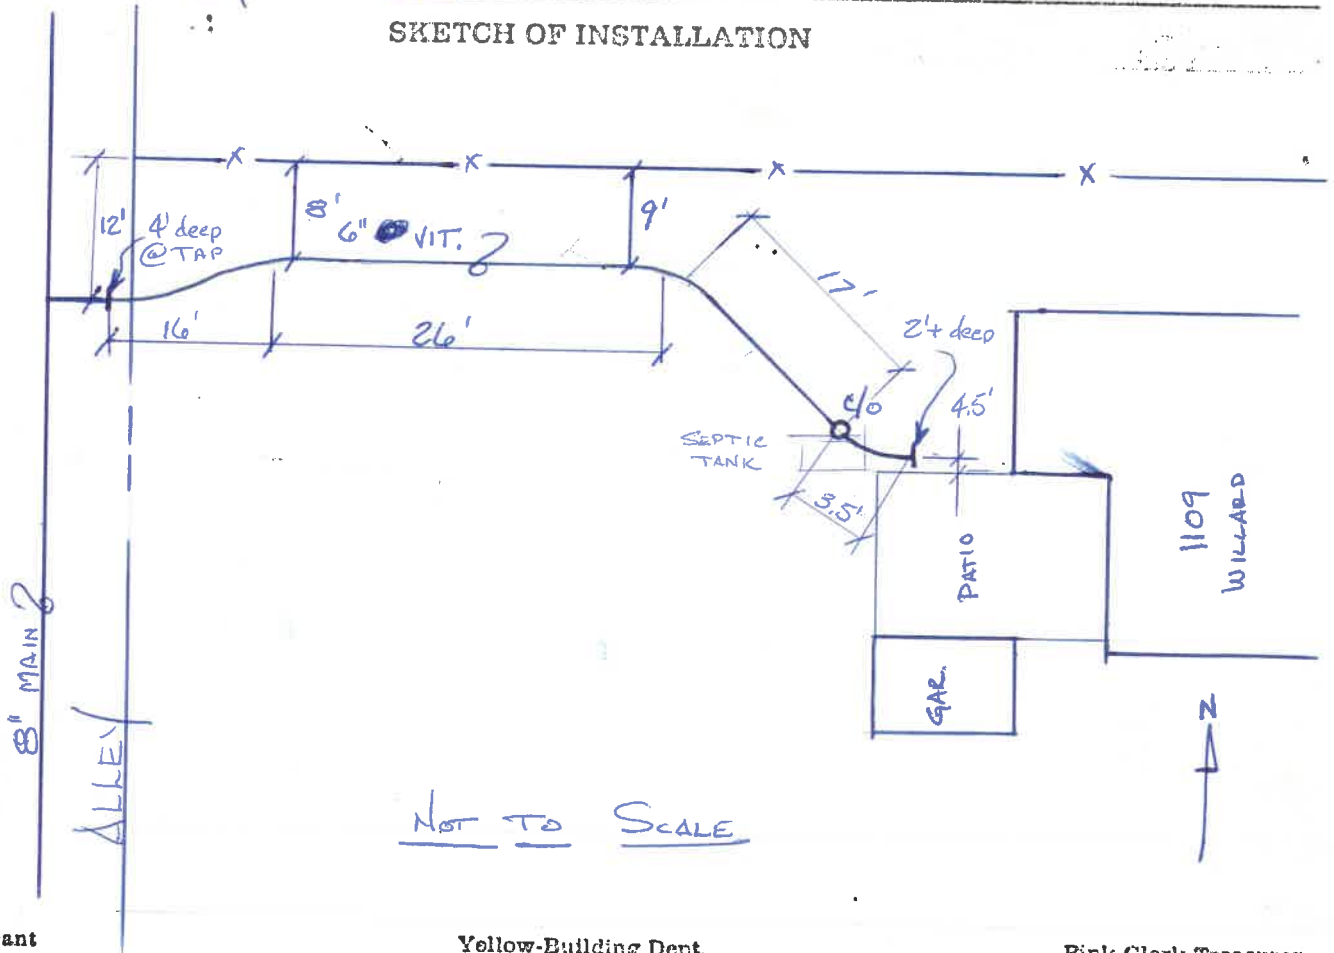

NOT TO SCALE