

SEWER TAPPING PERMIT

Issued by

The City of Napoleon Engineering Dept.

255 West Riverview Ave. Napoleon, Ohio 43545 Pn. 592-4010

Entry No. _____

Permit No. _____ Issued 5-20-91 Build. Permit No. _____

Permit Fee \$ 15.00

Job Location 1229 Woodlawn

Street Bond \$ _____

Lot _____

Date Paid 5-20-91

Issued By [Signature] sub div. or legal disc. _____

Owner Jerry Knepley Pn. _____

Address 1229 Woodlawn

Agent Jerry Glanz Pn. _____

Address _____

for office use only
.....

WORK INFORMATION

Sanitary Sewer Tap _____ Size of Tap _____ Size and Type of Sewer _____ Street to be Opened _____
yes no yes no

Storm Sewer Tap _____ Size of Tap _____ Size and Type of Sewer _____ Street to be Opened _____
yes no yes no

Street opening Agreement Approval Date _____ Opening Bond Fee (Set by Engineer) _____

READ AND SIGN BELOW; The undersigned hereby agrees complete the work described above and to make use of said sewers only as allowed by and in strict accordance with all applicable provisions of The Napoleon Engineering Dept. Rules and Regulations, The Napoleon Standard Specification for Water Main, Sanitary Sewer and Storm Sewer Construction and other Pertinent Sections of the Napoleon Code of Ordinances.

Date 5-20-91 Signature of Applicant [Signature]
Permit not valid without signature

INSPECTION RECORD ----- to be completed by the Field Inspector

Date Inspection is made _____ Size and Type of Sewer _____

Location _____ Depth _____ Type of Test _____ Additional Information _____

Date _____ Inspected By _____
signature of inspector

Sketch Of Installation on Back or Attached

PAID
MAY 20 1991
CITY OF NAPOLEON

end copy

Kneply


Sanitary

5-21-91

1229 Woodlawn

Jerry Glanz

woodlawn

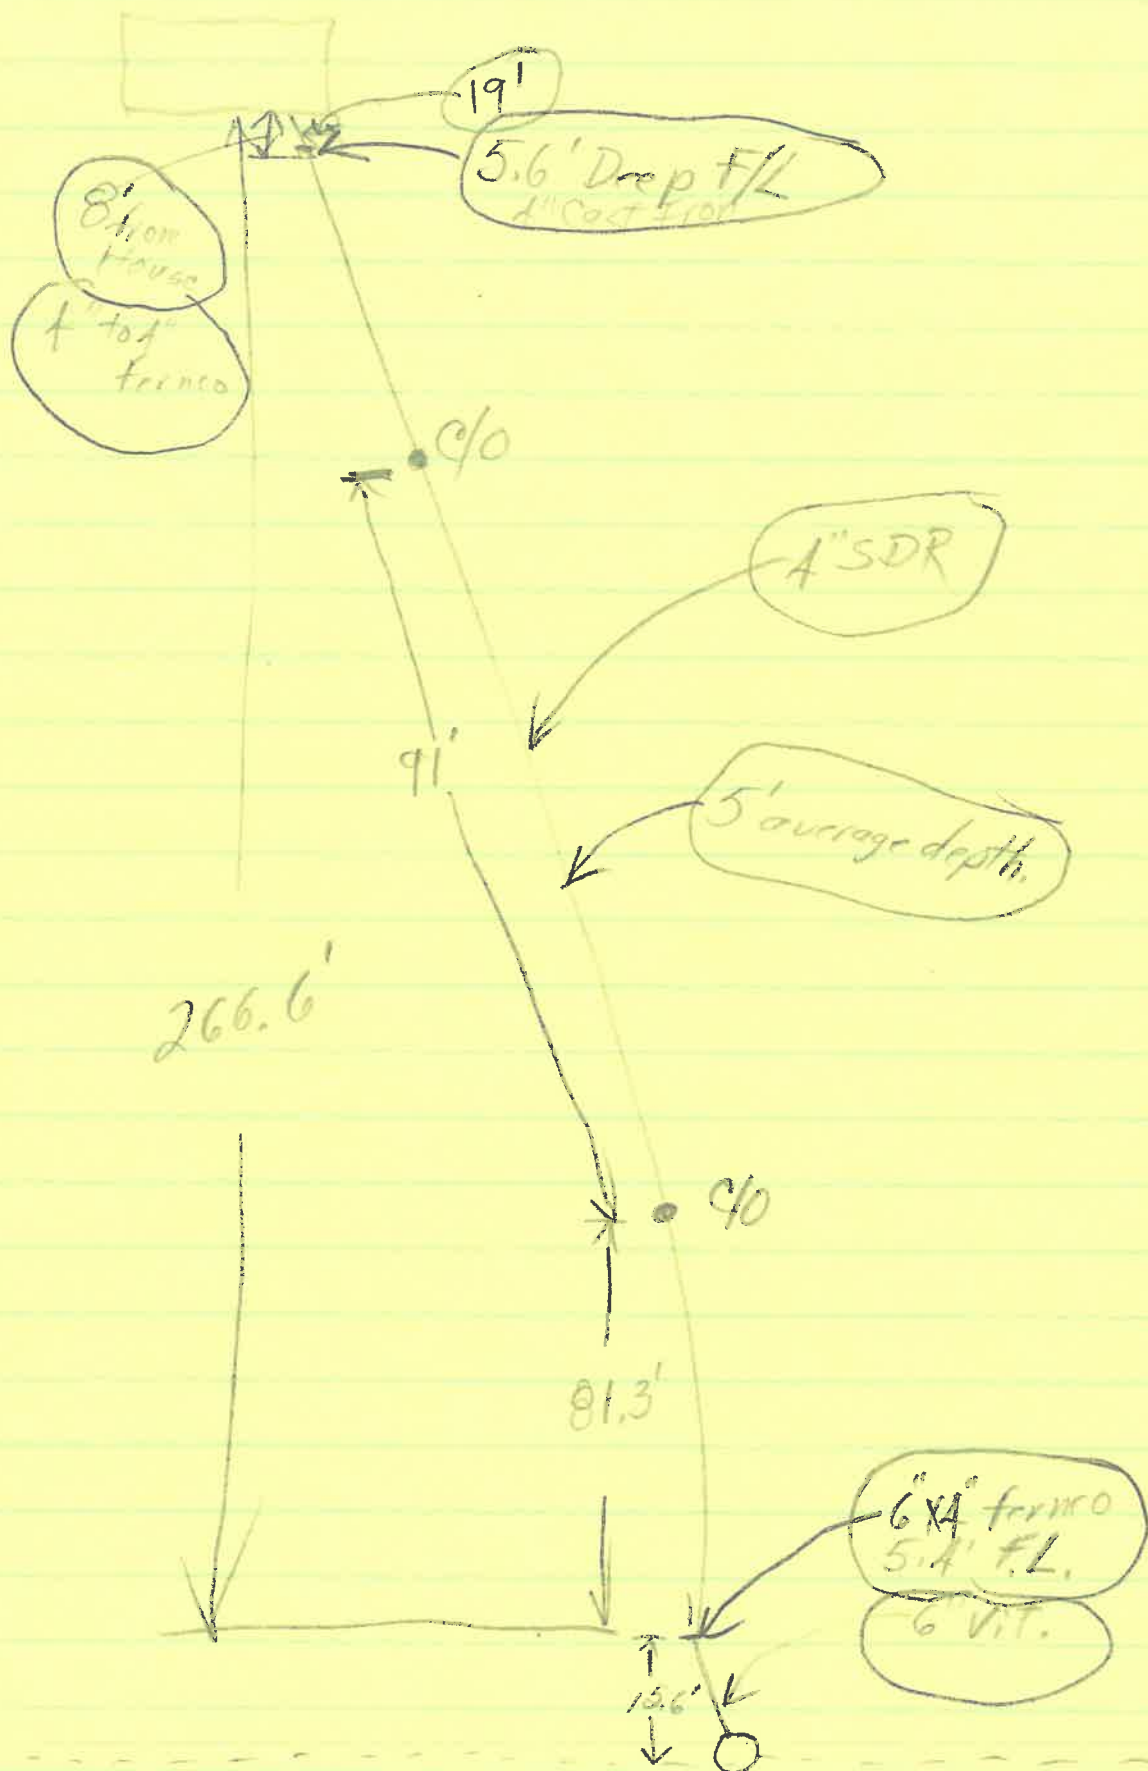

1229 Woodlawn Store



113-8
C/B

279'

11/11/10 Bank top

Overhouse Creek