

P E R M I T

CITY OF NAPOLEON
255 W. RIVERVIEW AVE
NAPOLEON, OHIO 43545

DIVISION OF BUILDING & ZONING
PH (419) 592-4010
FAX (419) 599-8393

PERMIT NO: 1534 DATE ISSUED: 03-13-03 ISSUED BY: BND

JOB LOCATION: 15453 CO RD M-2 EST. COST:

LOT #: SUBDIVISION NAME:

OWNER: WAISNER, SCOTT AGENT: BRANDT BROS ELECTRIC
ADDRESS: 15453 CO RD M-2 ADDRESS: 20884 CO RD U
CSZ: NAPOLEON, OH 43545 CSZ: ARCHBOLD, OH 43502
PHONE: PHONE: 419-267-3640

USE TYPE - RESIDENTIAL: OTHER:

ZONING INFORMATION

DIST: LOT DIM: AREA: FYRD: SYRD: RYRD:
MAX HT: # PKG SPACES: # LOADING SP: MAX LOT COV:

BOARD OF ZONING APPEALS:

WORK TYPE - NEW: X REPLMNT: ADD'N: ALTER: REMODEL:

WORK INFORMATION

SIZE - LGTH: WIDTH: STORIES: LIVING AREA SF:
GARAGE AREA SF: HEIGHT: BLDG VOL DEMO PERMIT:

WORK DESCRIPTION
ELEC SERVICE
200 UG OUTSIDE

FEE DESCRIPTION PAID DATE FEE AMOUNT DUE

TOTAL FEES DUE 0.00

DATE

APPLICANT SIGNATURE

CITY OF NAPOLEON

ELECTRIC METER BASE RELEASE FORM

THIS DOCUMENT ENTITLES THE HOLDER TO "ONE" ELECTRIC METER BASE
(Please pickup at the City operations garage 1775 Industrial Drive).

PERMIT #: 1534

ISSUED: 03-13-2003

JOB LOCATION: 15453 CO RD M-2

WORK DESCRIPTION: ELEC SERVICE

OWNER: WAISNER, SCOTT

ADDRESS: 15453 CO RD M-2 NAPOLEON, OH 43545

OWNER PHONE:

CONTRACTOR: BRANDT BROS ELECTRIC

ADDRESS: 20884 CO RD U ARCHBOLD, OH 43502

CONTRACTOR PHONE: 419-267-3640

ELECTRIC SERVICE UPGRADE _____ NEW SERVICE INSTALLATION

INDUSTRIAL _____ COMMERCIAL _____ RESIDENTIAL 1PHASE 3PHASE _____

SIZE OF SERVICE 100AMP _____ 150AMP _____ 200AMP 400AMP _____ OTHER _____

HUB SIZE - 1 1/4" _____ 1 1/2" _____ 2" _____

DESIRED VOLTAGE 120/240 OTHER _____

UNDERGROUND SERVICE OVERHEAD SERVICE _____

=====

DATE COMPLETED: _____ APPROVED BY: _____

OLD METER NUMBER: _____ NEW METER NUMBER: _____

COMMENTS:

CITY OF NAPOLEON

ELECTRIC METER BASE RELEASE FORM

THIS DOCUMENT ENTITLES THE HOLDER TO "ONE" ELECTRIC METER BASE
(Please pickup at the City operations garage 1775 Industrial Drive).

PERMIT #: 1534

ISSUED: 03-13-2003

JOB LOCATION: 15453 CO RD M-2

WORK DESCRIPTION: ELEC SERVICE

OWNER: WAISIVER, SCOTT

ADDRESS: 15453 CO RD M-2 NAPOLEON, OH 43545

OWNER PHONE:

CONTRACTOR: BRANDT BROS ELECTRIC

ADDRESS: 20884 CO RD U ARCHBOLD, OH 43502

CONTRACTOR PHONE: 419-267-3640

ELECTRIC SERVICE UPGRADE _____ NEW SERVICE INSTALLATION X

INDUSTRIAL _____ COMMERCIAL _____ RESIDENTIAL X 1PHASE X 3PHASE _____

SIZE OF SERVICE 100AMP _____ 150AMP _____ 200AMP X 400AMP _____ OTHER _____

HUB SIZE - 1 1/4" _____ 1 1/2" _____ 2" _____

DESIRED VOLTAGE 120/240 X OTHER _____

UNDERGROUND SERVICE X OVERHEAD SERVICE _____

=====

DATE COMPLETED: _____ APPROVED BY: _____

OLD METER NUMBER: _____ NEW METER NUMBER: _____

COMMENTS:

P E R M I T

CITY OF NAPOLEON
255 W. RIVERVIEW AVE
NAPOLEON, OHIO 43545

DIVISION OF BUILDING & ZONING
PH (419) 592-4010
FAX (419) 599-8393

PERMIT NO: 1534 DATE ISSUED: 03-13-03 ISSUED BY: BND

JOB LOCATION: 15453 CO RD M-2 EST. COST:

LOT #: SUBDIVISION NAME:

OWNER: WAISIVER, SCOTT AGENT: BRANDT BROS ELECTRIC
ADDRESS: 15453 CO RD M-2 ADDRESS: 20884 CO RD U
CSZ: NAPOLEON, OH 43545 CSZ: ARCHBOLD, OH 43502
PHONE: PHONE: 419-267-3640

USE TYPE - RESIDENTIAL: OTHER:

ZONING INFORMATION

DIST: LOT DIM: AREA: FYRD: SYRD: RYRD:
MAX HT: # PKG SPACES: # LOADING SP: MAX LOT COV:

BOARD OF ZONING APPEALS:

WORK TYPE - NEW: X REPLMNT: ADD'N: ALTER: REMODEL:

WORK INFORMATION

SIZE - LGTH: WIDTH: STORIES: LIVING AREA SF:
GARAGE AREA SF: HEIGHT: BLDG VOL DEMO PERMIT:

WORK DESCRIPTION
ELEC SERVICE
200 UG OUTSIDE

FEE DESCRIPTION PAID DATE FEE AMOUNT DUE

TOTAL FEES DUE 0.00

DATE

APPLICANT SIGNATURE

Application for Upgrade or New Electrical Service Outside City Limits

Location of new service 15453 Napoleon 43545
Street address City Zip

Scott Waisner 15453 Co. Rd M-2
Owner name Current address

Napoleon 43545
City Zip Daytime phone

Please provide the following if this is a new electrical service or a re-location of an existing service:

A dimensioned building site plan showing lot size, building setbacks from property lines, dimensioned building footprint, location of new electric service meter and appurtenances, location of all existing and proposed underground utilities (septic tank, leech field, gas lines, electric lines, telephone lines, cable TV lines and all other).

Please check the applicable areas below:

1. Size of service desired: 100 amp , 200 amp , 400 amp , other _____
2. Type of service desired: Single phase , Three phase .
3. Installation type desired: Underground , Overhead .

Once you have completed this form and provided the requested information, submit it to the City Building Department for processing. Once processed, we will print a "no-fee" permit and an electric meter base release form. You will receive a copy of these documents along with a copy of the City of Napoleon Electric Service Entrance Minimum Specifications. The City will provide a new electric meter base. To obtain one you will need to present the meter base release form to the City Electrical Department @ 1775 Industrial Drive Napoleon.


It is very important to understand the installation specifications and install the electric service entrance accordingly. Services not meeting the City minimum standards and the National Electric Code will not be connected.


The Building Department will forward a copy of the electric meter base release form and site plan to the City Electric Department. Mr. Rick Barnes (Electrical Construction Inspector) will contact you within a reasonable time to make arrangements to meet with you on the matter. He will discuss with you your options and costs for electric service to your site. A formal estimate/invoice will be drafted and forwarded to you outlining the costs of the installation of necessary equipment and materials to service your site. This estimate/invoice must be paid in full before the initiation of the installation will occur.

For questions regarding this procedure please contact the City engineering department at (419) 592-4010. For questions regarding estimates, electric service entrance layout/routing or costs associated with installation, please call the electric department at (419) 592-9116.

***It is against the law to tamper with the City electrical equipment or wires. You may not disconnect or re-connect an existing or new electrical service yourself.**

SCOTT WAINNER
15453 CR M2
Napoleon Ohio
43545

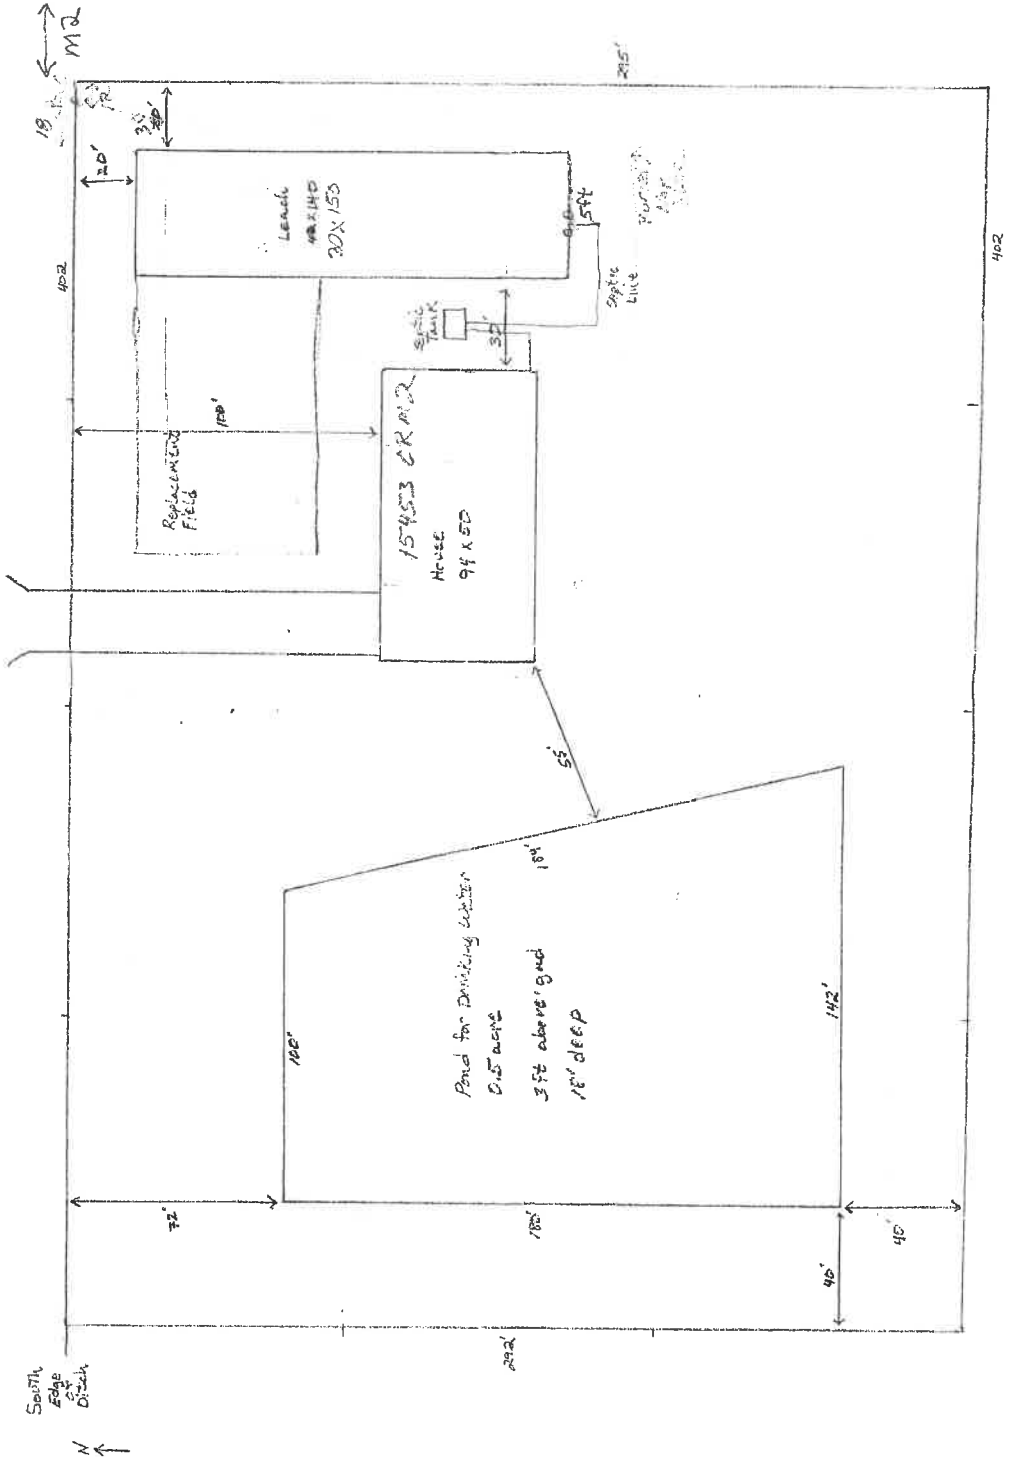

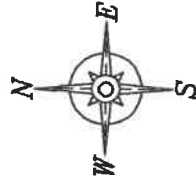

CO RD M2

15 KVA GD

08395

170'


INST 500 MCM
UNDERGROUND ELECTRIC

15-453

105'

INST 470 TRIPLEX
UNDERGROUND SERVICE

INST SEC PED

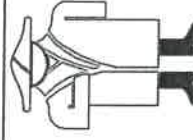

Napoleon Power & Light

1775 Industrial Drive Napoleon, Ohio

ITEM 15-453 COUNTY ROAD M2

DATE 4/1/03


W.O.#

J.O.#

J02375

DRAWN BY

MTD

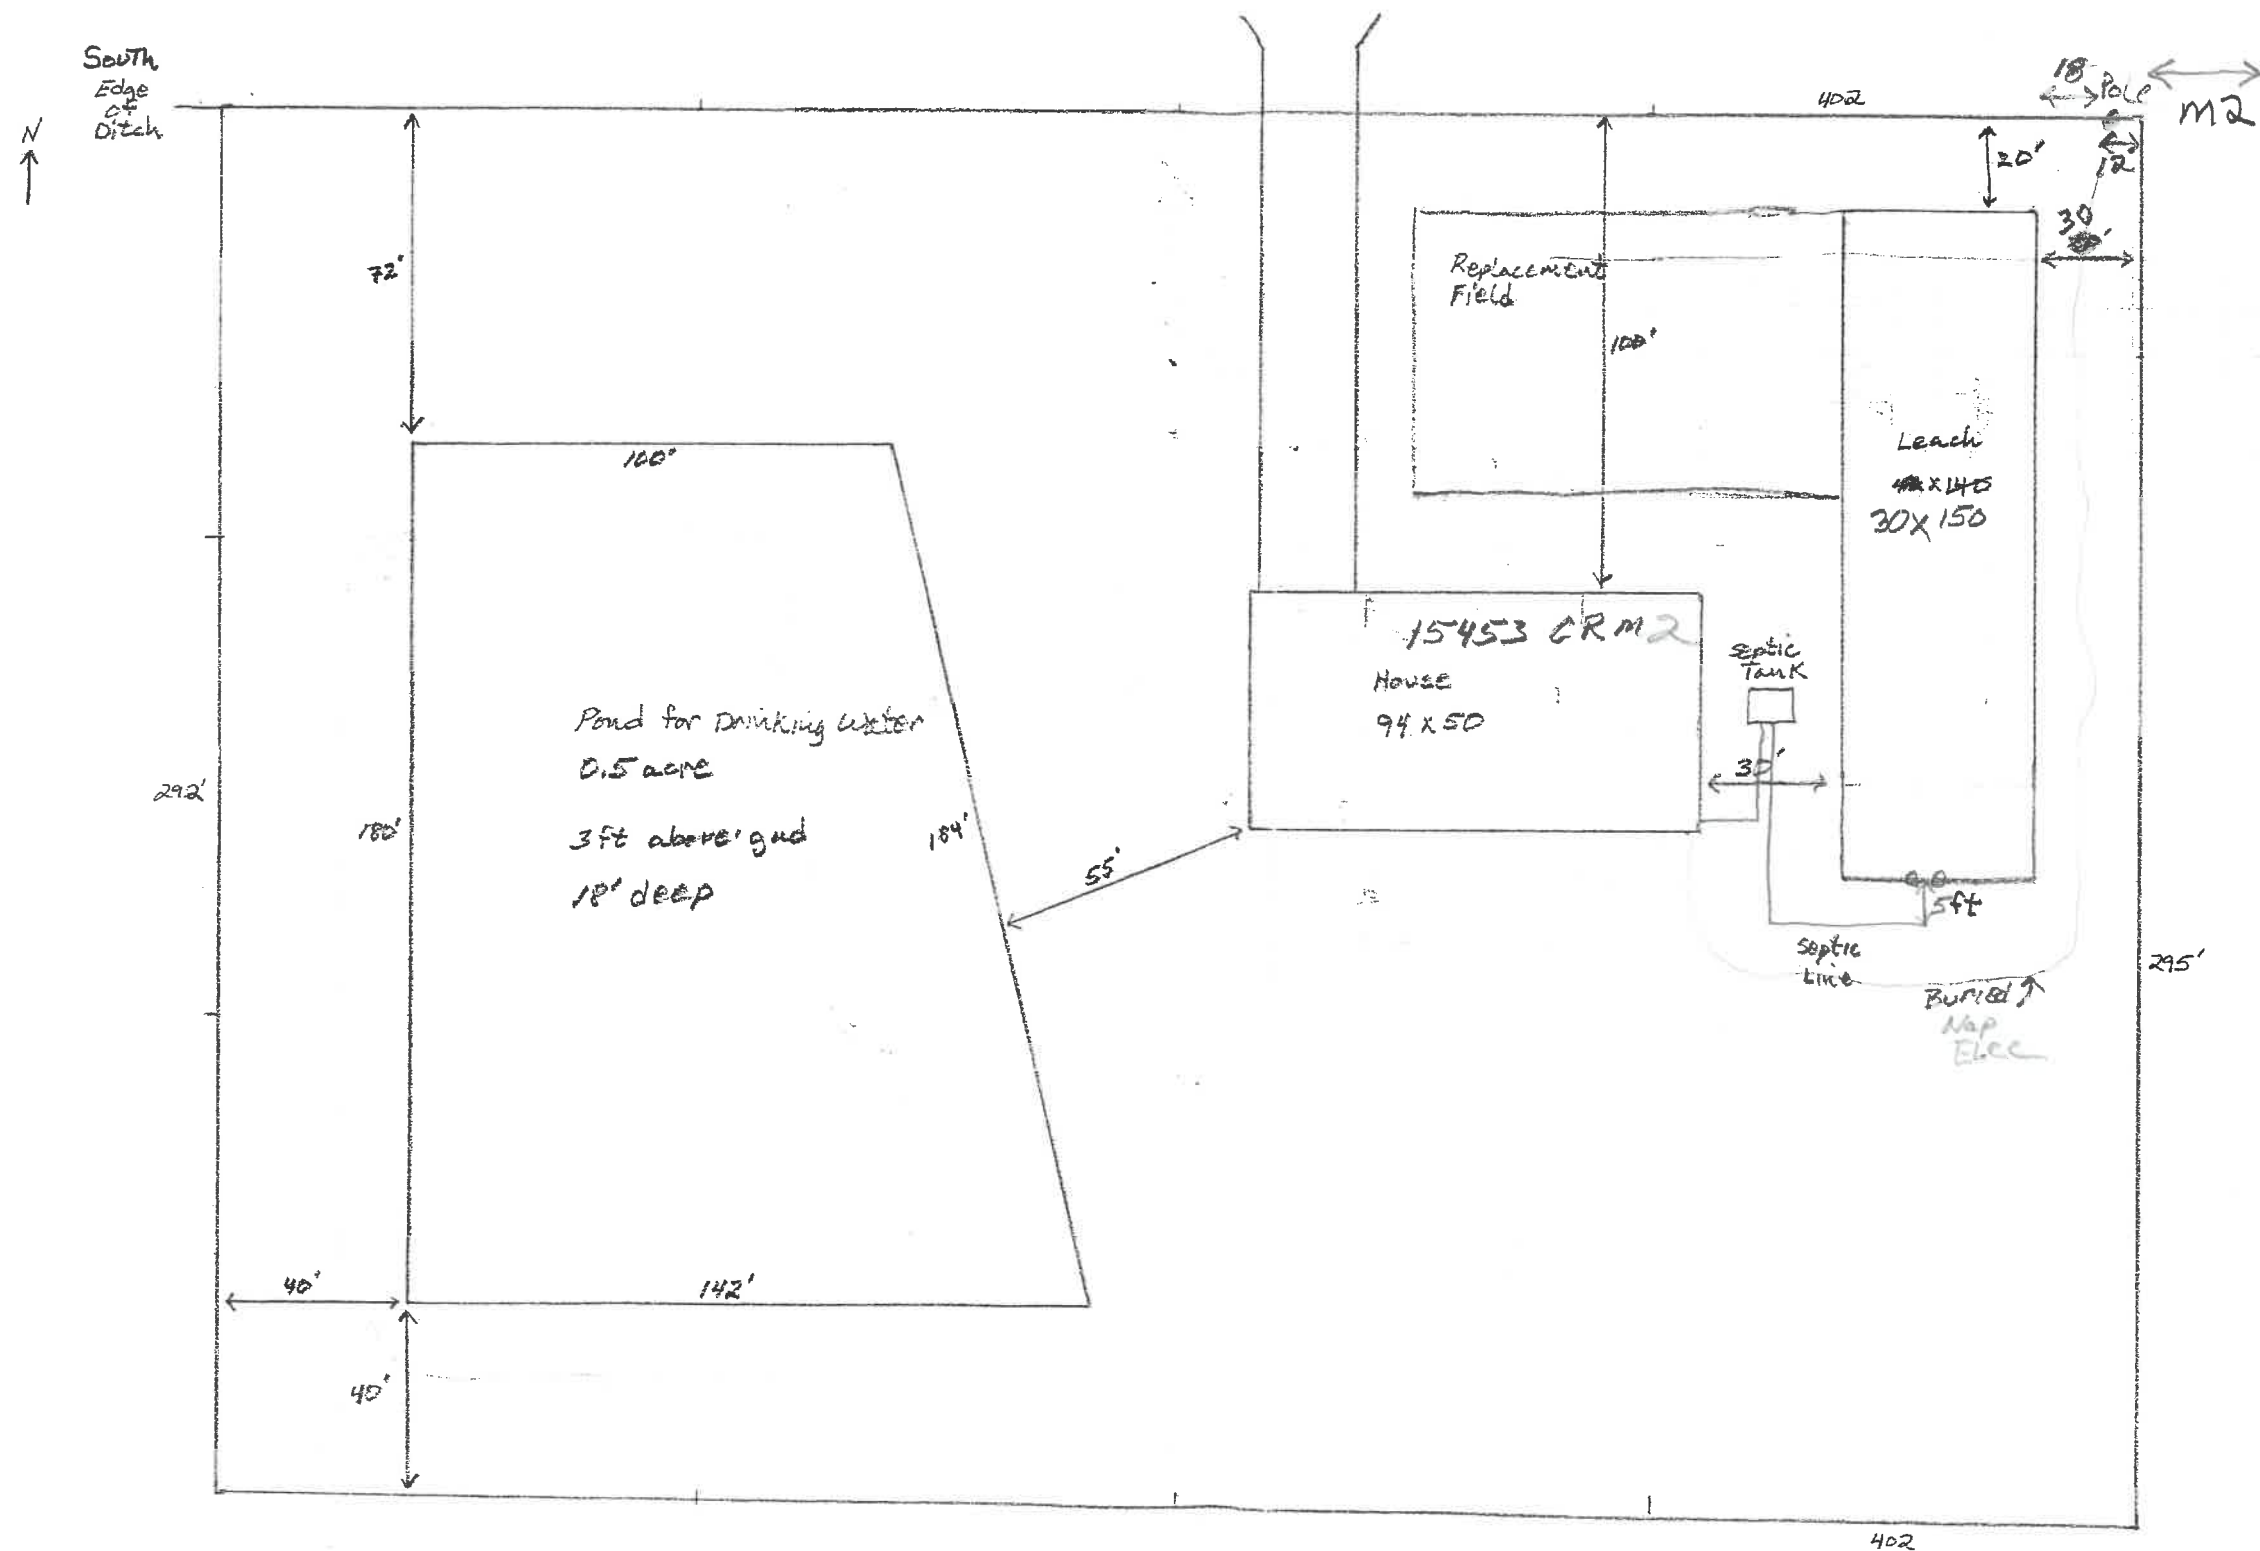

SCOTT WAISNER
 15453 CR M2
 Napoleon Ohio
 43545