

1'-3" | NAPOLEON MUNICIPAL COURT


1 SET

EXTERIOR LETTERS
 SCALE 1/2" = 1'-0"
 15" INJECTION MOLDED PLASTIC LETTERS.
 HELVETICA LETTER STYLE
 BAKED ENAMEL FINISH
 FINISH COLOR: GEMINI #2030 GREEN
 STUD MOUNTED

1'-9"
 6" | CIVIL
 1 SET


8'-4"
 6" | CRIMINAL AND TRAFFIC
 1 SET

INTERIOR LETTERS
 SCALE 1" = 1'-0"
 6" HELVETICA LETTERS WITH SATIN ALUMINUM FINISH
 STUD MOUNTED

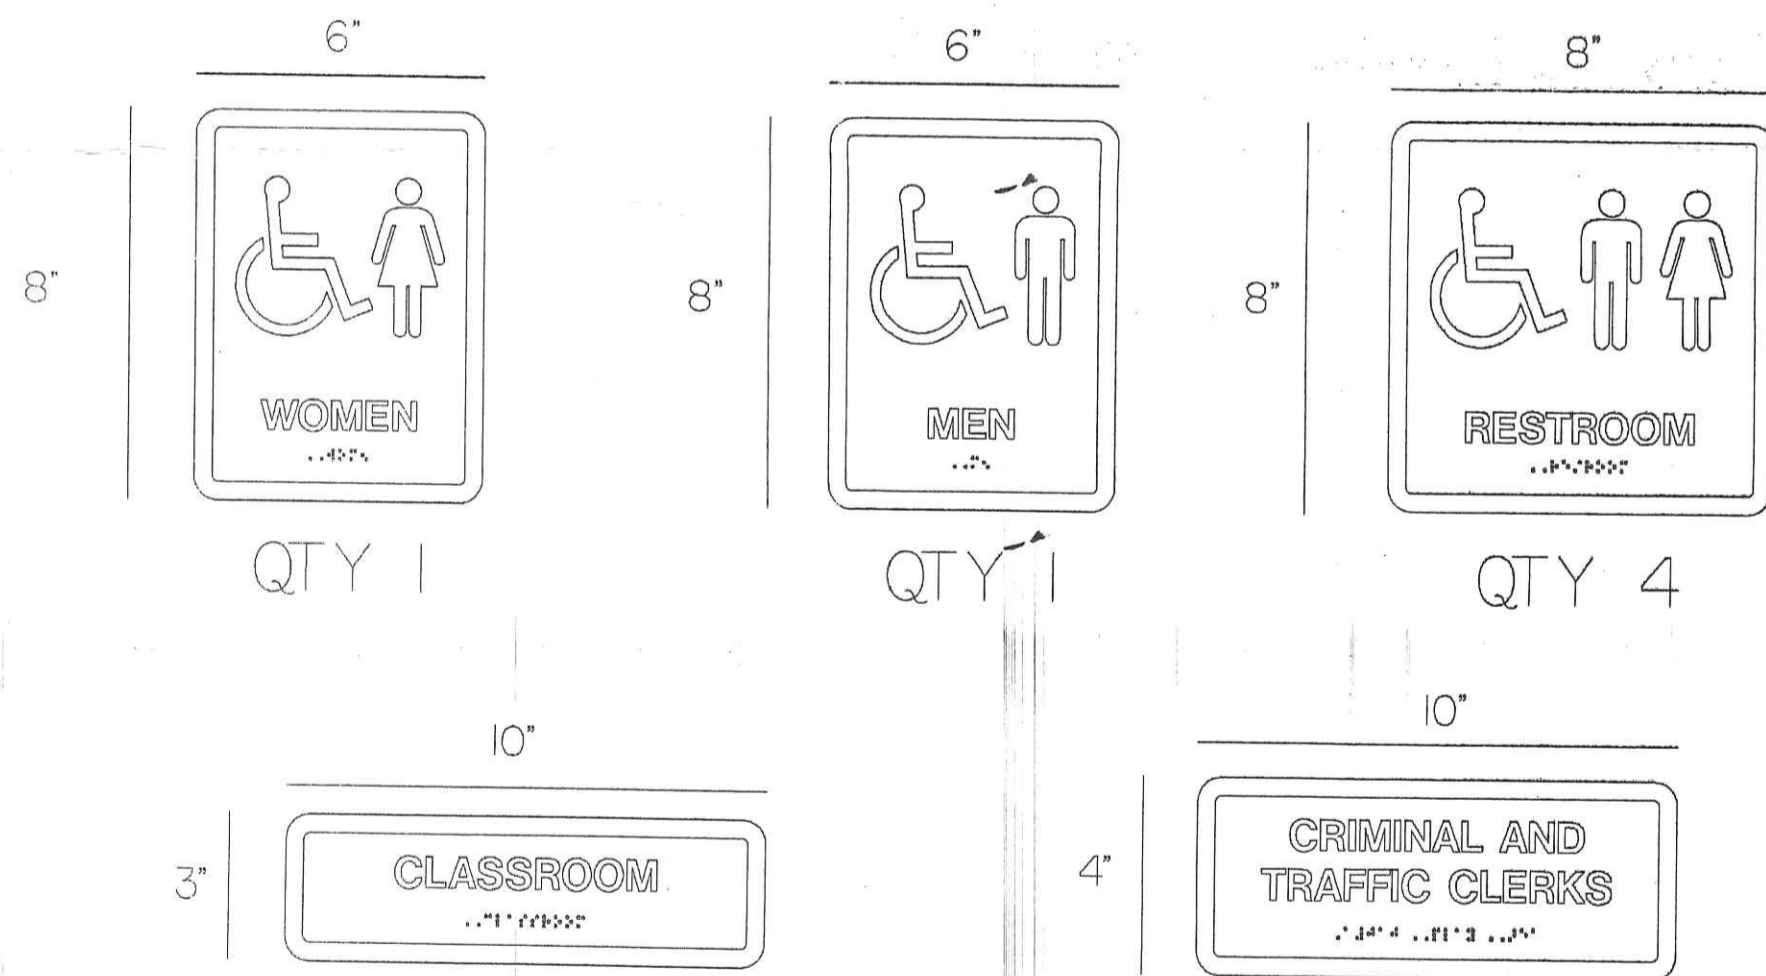

SCALE 3" = 1' 0"
 SIGNS FROM BEST PRODUCTS HC300 SERIES
 DRAWINGS ARE SAMPLE LAYOUTS AND ACTUAL SIGNS MAY VARY
 BACKGROUND COLOR: BEIGE
 LETTER AND SYMBOL AND BORDER COLOR: MATTE
 LETTERS ARE 5/8" HIGH
 SYMBOLS ARE 3 1/4" HIGH
 BORDER IS 3/8" WIDE. RADIUS 1/2"
 LETTERS, BRAILLE, AND BORDER RAISED 1/32"
 TAPE & SILICONE MOUNTED

- SIGNAGE LIST
- 103 ATTORNEY/CLIENT
 - 104 ATTORNEY/CLIENT
 - 105 WOMEN (W/ HC SYMBOLS)
 - 106 MEN (W/ HC SYMBOLS)
 - 108 PROBATION
 - 109 PROSECUTOR
 - 110 BAILIFF
 - 111 COURT ROOM
 - 113 HOLDING
 - 114 HOLDING
 - 115 ATTORNEY
 - 116 RESTROOM (W/ HC SYMBOLS)
 - 118 JUDGES OFFICE
 - 119 RESTROOM (W/ HC SYMBOLS)
 - 120 BREAK ROOM
 - 121 RESTROOM (W/ HC SYMBOLS)
 - 122 JANITOR
 - 124 CLERK'S OFFICE
 - 125 CLERK'S STORAGE
 - 126 WORKROOM
 - 127 JURY ROOM
 - 128 RESTROOM (W/ HC SYMBOLS)
 - 129 CIVIL CLERKS
 - 130 CIVIL WORKROOM
 - 131 CRIMINAL AND TRAFFIC CLERKS
 - 132 DATA
 - 133 STORAGE
 - 134 CLOSET

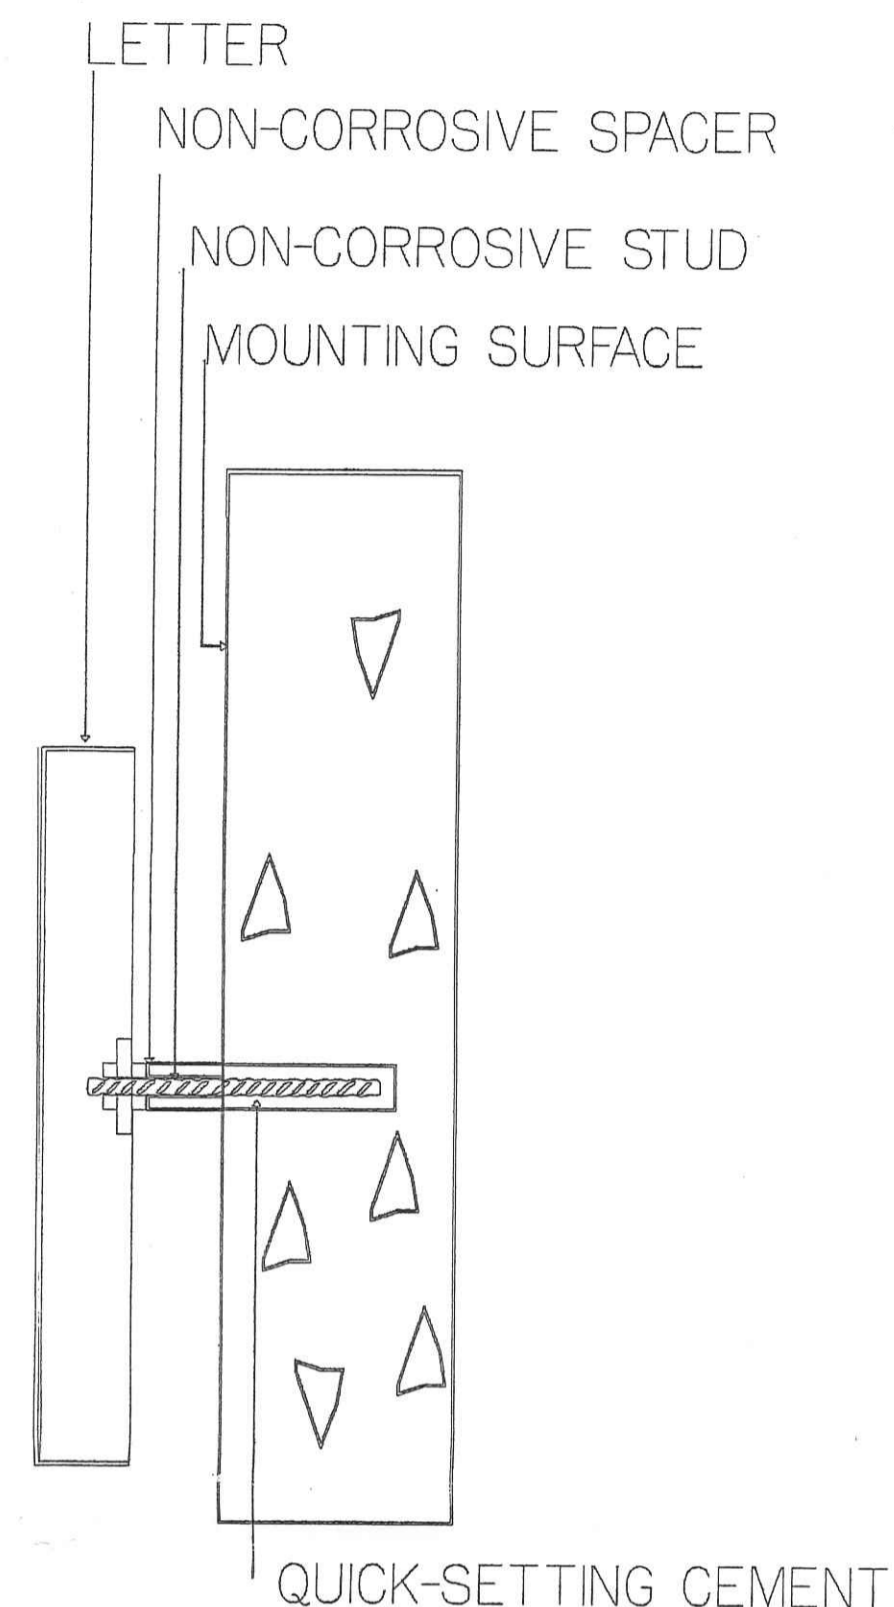

NO EXCEPTIONS NOTED
 EXCEPTIONS NOTED
 REVISE AND RESUBMIT
 Checking is only for conformance with the design concept of the Project and for compliance with the information given in the Contract Documents and shall not extend to means, methods, techniques, sequences or procedures of construction or to safety precautions or programs incident thereto. Marking or comments shall not be construed as relieving the Contractor from compliance with the plans and specifications. The Contractor shall verify all dimensions, quantities and field conditions.
 POGGEMEYER DESIGN GROUP, INC.
 ITEM NO. 1044 BY *Adrian*
 JOB NO. 1120-011 DATE 2/13/16

1819 Acknowled

NAPOLEON MUNICIPAL COURT		
WO # 8494		05-07-08
ARCHITECTURAL ARTS, DIVISION OF DIGIMATICS, INC.		
SIGNAGE	JKB	