

SEWER TAPPING PERMIT

Issued by

The City of Napoleon Engineering Dept.

255 West Riverview Ave. Napoleon, Ohio 43345 Pn. 592-4010

Entry No. \_\_\_\_\_

Permit No. SA0162 Issued 3-11-91 Build. Permit No. \_\_\_\_\_

Job Location 1015 Fairview Dr.

Lot 18 Brillhart Addition sub div. or legal disc.

Issued By BND

Owner Robert Morrison Pn. \_\_\_\_\_

Address 1015 Fairview Dr

Agent Jerry Glanz Pn. 599-4103

Address 6 Lakeview Napoleon.

Permit Fee \$ No fee

Street Bond \$ \_\_\_\_\_

Date Paid \_\_\_\_\_

for office use only

WORK INFORMATION

Sanitary Sewer Tap  yes  no Size of Tap 6 Size and Type of Sewer \_\_\_\_\_ Street to be Opened  yes  no

Storm Sewer Tap \_\_\_\_\_ Size of Tap \_\_\_\_\_ Size and Type of Sewer \_\_\_\_\_ Street to be Opened  yes  no

Street opening Agreement Approval Date \_\_\_\_\_ Opening Bond Fee (Set by Engineer) \_\_\_\_\_

READ AND SIGN BELOW; The undersigned hereby agrees complete the work described above and to make use of said sewers only as allowed by and in strict accordance with all applicable provisions of The Napoleon Engineering Dept. Rules and Regulations, The Napoleon Standard Specification for Water Main, Sanitary Sewer and Storm Sewer Construction and other Pertinent Sections of the Napoleon Code of Ordinances.

Date 3-11-91 Signature of Applicant Jerry Glanz Permit not valid without signature

INSPECTION RECORD


to be completed by the Field Inspector

Date Inspection is made 3-12-91 Size and Type of Sewer 4" P.V.C.

Location \_\_\_\_\_ Depth \_\_\_\_\_ Type of Test \_\_\_\_\_ Additional Information \_\_\_\_\_

Date 3-12-91 Inspected By Malcolm Helberg signature of inspector

Sketch Of Installation on Back or Attached

 

SEWER TAPPING PERMIT

Issued by

The City of Napoleon Engineering Dept.

233 West Riverview Ave. Napoleon, Ohio 43345 Pn. 592-4010

Entry No. \_\_\_\_\_

Permit No. SA0162 Issued 3-11-91 Build. Permit No. \_\_\_\_\_

Job Location 1015 Fairview Dr.

Lot 18 Brillhart Addition

Issued By BND sub div. or legal disc.

Owner Robert Morrison Pn. \_\_\_\_\_

Address 1015 Fairview Dr

Agent Jerry Glanz Pn. 599-4103

Address 6 Lakeview Napoleon

Permit Fee \$ No fee

Street Bond \$ \_\_\_\_\_

Date Paid \_\_\_\_\_

for office use only

WORK INFORMATION

Sanitary Sewer Tap  yes  no Size of Tap 6 Size and Type of Sewer \_\_\_\_\_ Street to be Opened  yes  no

Storm Sewer Tap \_\_\_\_\_ yes  no Size of Tap \_\_\_\_\_ Size and Type of Sewer \_\_\_\_\_ Street to be Opened  yes  no

Street opening Agreement Approval Date \_\_\_\_\_ Opening Bond Fee (Set by Engineer) \_\_\_\_\_

READ AND SIGN BELOW; The undersigned hereby agrees complete the work described above and to make use of said sewers only as allowed by and in strict accordance with all applicable provisions of The Napoleon Engineering Dept. Rules and Regulations, The Napoleon Standard Specification for Water Main, Sanitary Sewer and Storm Sewer Construction and other Pertinent Sections of the Napoleon Code of Ordinances.

Date 3-11-91 Signature of Applicant Jerry Glanz permit not valid without signature

INSPECTION RECORD

Date Inspection is made 3-12-91 Size and Type of Sewer 4" P.U.C. to be completed by the Field Inspector


Location \_\_\_\_\_ Depth \_\_\_\_\_ Type of Test \_\_\_\_\_ Additional Information See reverse

Date 3-12-91 Inspected By Malcolm Helberg signature of inspector

Sketch Of Installation on Back or Attached

3-12-91

JERRY GLAUZ (Contractor)  
Robert Morrison (Owner)

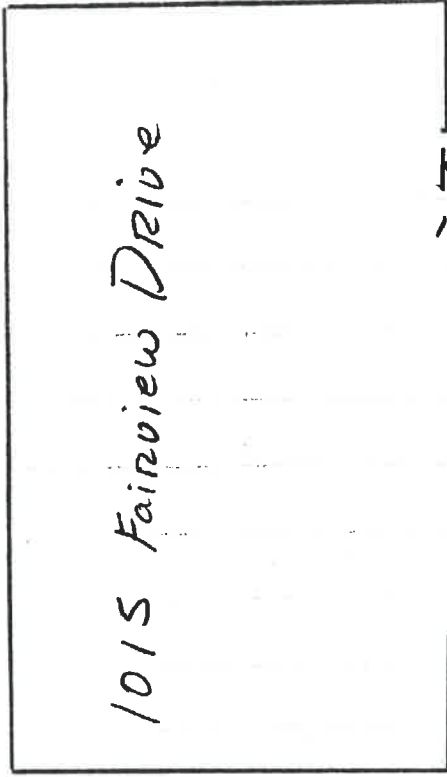


1015 Fairview Drive



Garage

8" P.V.C. SANITARY

6" to 4" Reducer  
El. 656.07

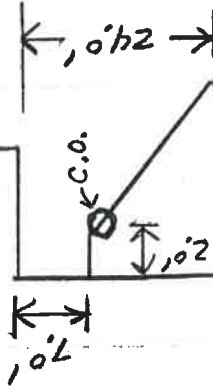

4" S.P.R. 35 P.V.C.  
2.5" to 6.0' deep

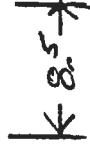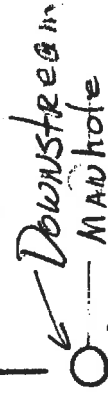

Fairview Drive

18" P.V.C. Intercept