BECK'S CONSTRUCTION
R.R. # 3
NAPOLEON, OHIO

1760 ~~1868~~ sq. ft. GROSS AREA
400 sq. ft. GARAGE
1360 ~~1268~~ sq. ft. NET LIVING AREA

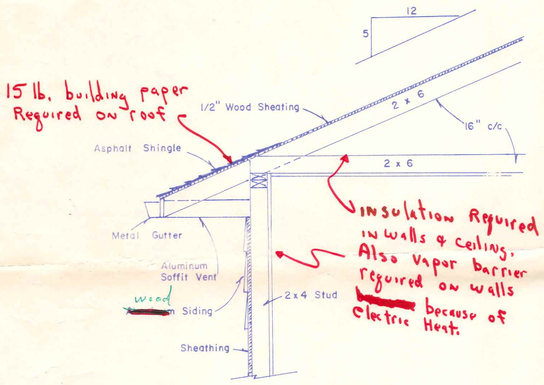

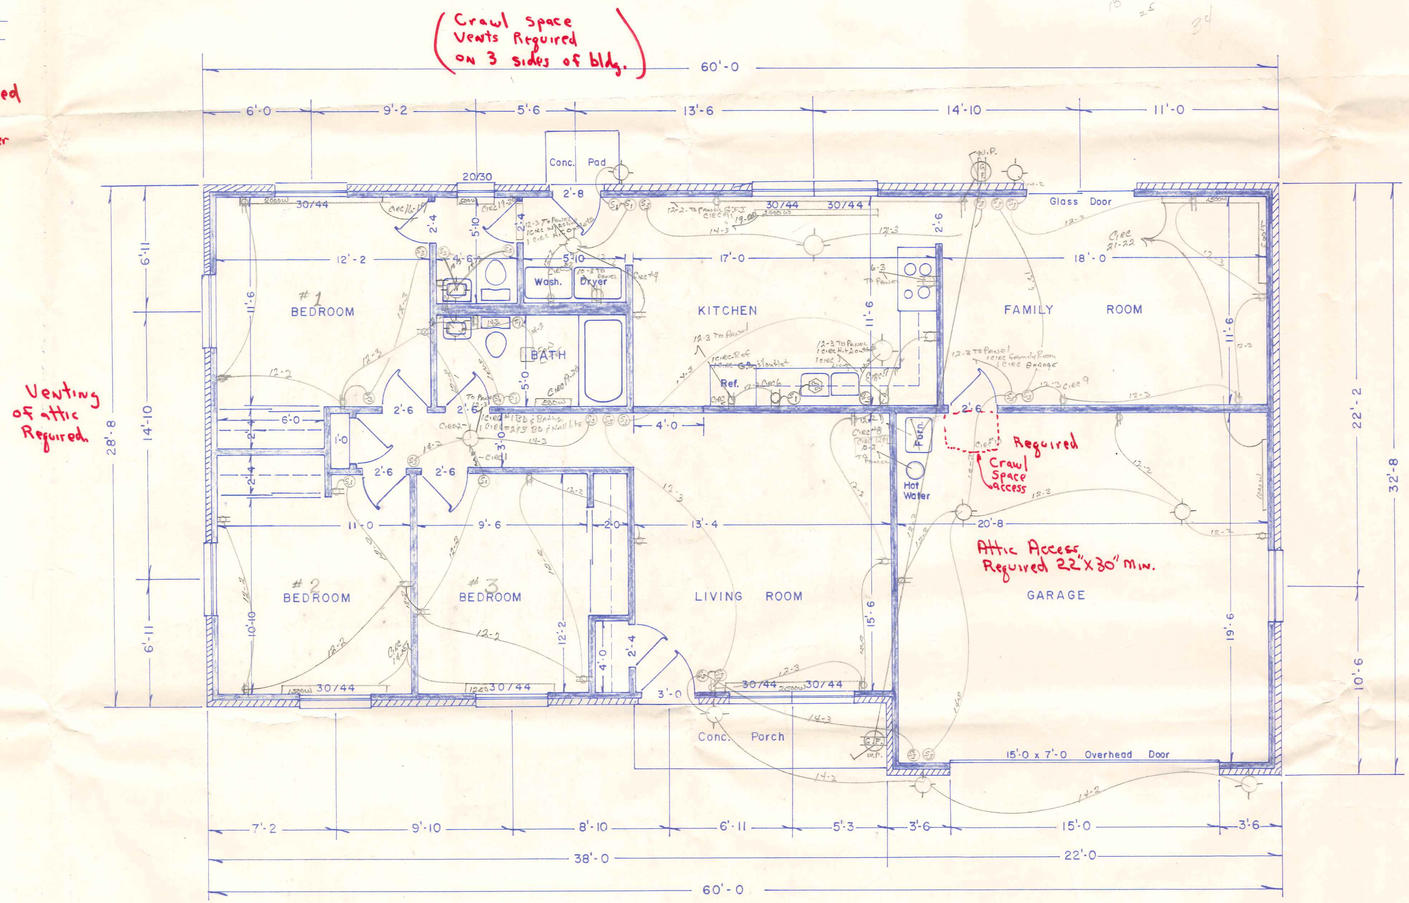

NOTE: Exterior finish brick
Roof pitch 5" in 12"
Roof overhang 2'-8
Rafter & ceiling joist 2" x 6"
Floor joist 2" x 10"
Subfloor 3/4" plywood
3 1/2"-10" block on 8" x 16" footer

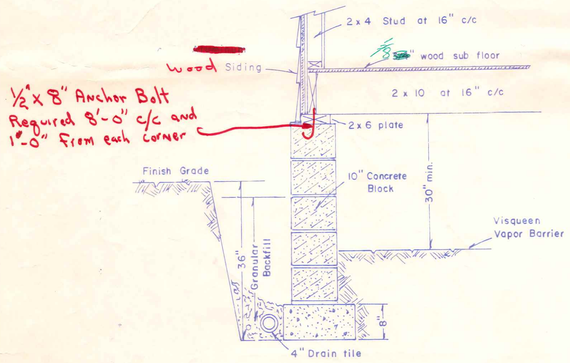

WALL SECTION DETAIL

FLOOR PLAN
Scale: 1/4" = 1'

203 Hurst

Prepared by
DEFIANCE DRAFTING SERVICE
1939 EAST SECOND STREET
DEFIANCE, OHIO

BECK'S CONSTRUCTION
R.R. # 3
NAPOLEON, OHIO

1760 ~~1368~~ sq. ft. GROSS AREA
400 sq. ft. GARAGE
1360 ~~1268~~ sq. ft. NET LIVING AREA

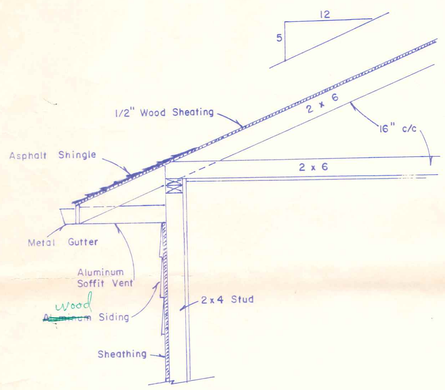

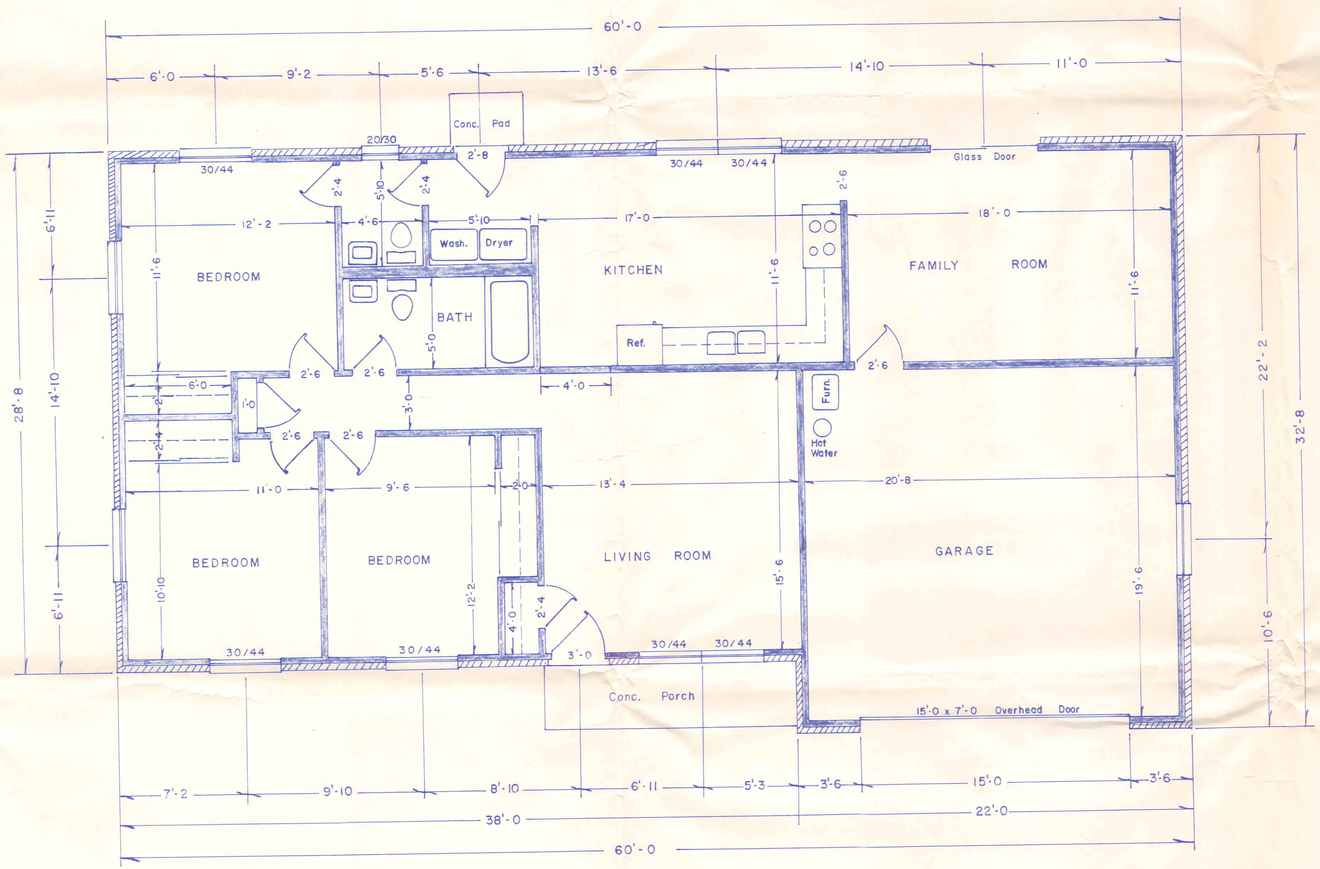

FLOOR PLAN
Scale: 1/4" = 1'

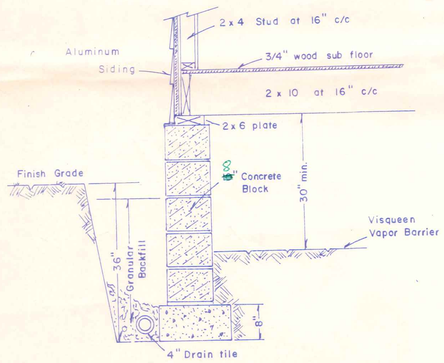

WALL SECTION DETAIL

NOTE: Exterior finish brick
Roof pitch 5" in 12"
Roof overhang 2'-8
Rafter & ceiling joist 2" x 6"
Floor joist 2" x 10"
Subfloor 3/4" plywood
3 1/2"-10" block on 8" x 16" footer

Prepared by
DEFIANCE DRAFTING SERVICE
1939 EAST SECOND STREET
DEFIANCE, OHIO