APPLICATION FOR PERMIT TO TAP SEWER

(Print or Type)

Owner George E. Higbee

Address 1449 Ohio

Contractor Mort Cordes Plumbing

Address RT 4 Napoleon Tel.

NO. —

BLDG. PERMIT —

PERMIT FEE $ —

DATE PAID

for office use only

LOCATION OF CONNECTION

Street and No. 1405 Scott St. Sanitary X Storm

Lot No. 19+20 Subdivision Size of Tap 6"

Size and Type of Sewer ALL WORK MUST BE INSPECTED

I certify that the sewer will be used only as indicated and no other Drainage will be connected.

Date Aug 30, 1979 Signature George E. Higbee

owner-builder agent

do not write below this line

INSPECTION RECORD

Date Inspected 8-30-79 Size and Type of Sewer 4" PVC

Location SIDE TO FRONT Depth SEE DRWG Type of Test N/A.

Inspected and Approved By: Bruce Menard 8-30-79

Inspector Date

Additional Information SEPTIC TANK NOT FILLED

Send copy to:

SKETCH OF INSTALLATION

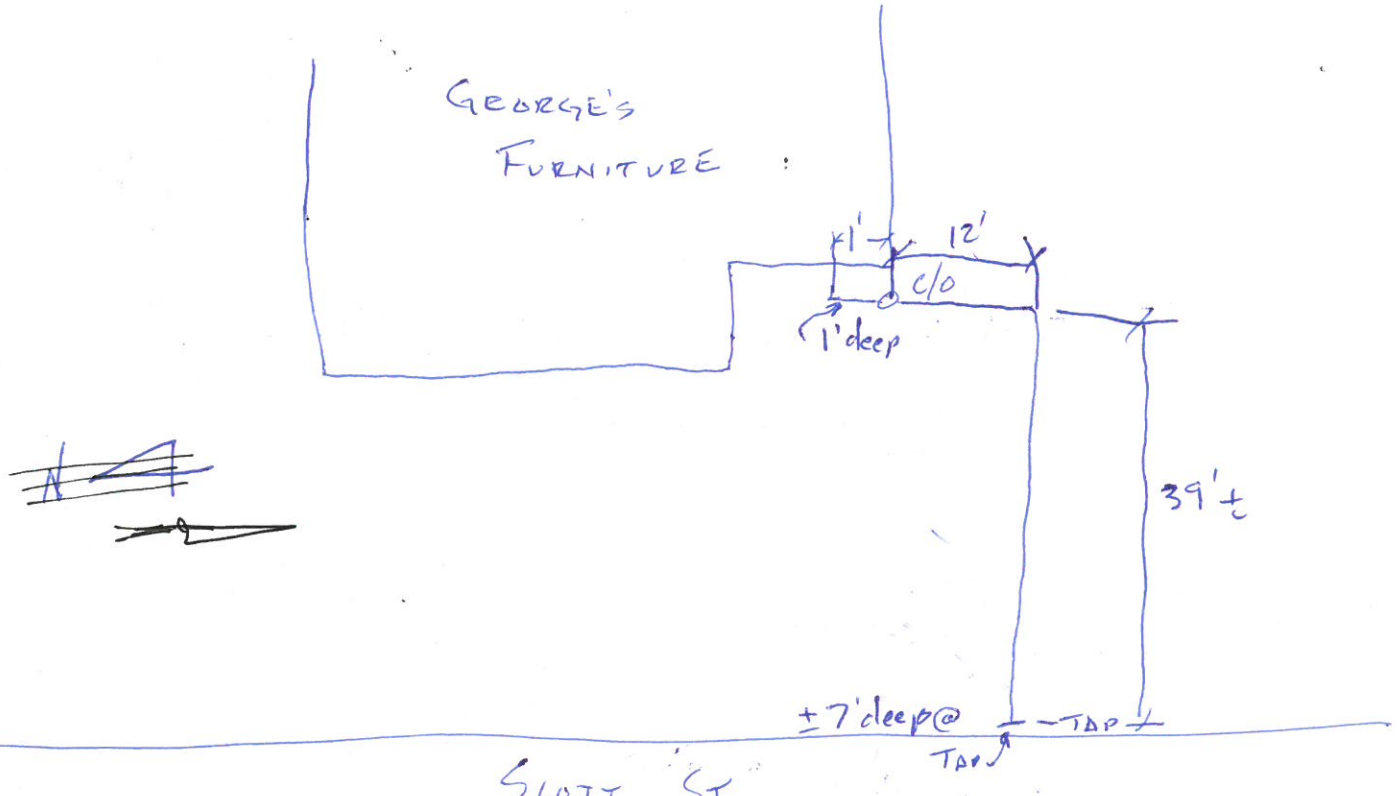

White-Applicant Yellow-Building Dept. Pink-Clerk-Treasurer