APPLICATION FOR PERMIT TO TAP SEWER

(Print or Type)

Owner: Laura Barnes

Address: 1103 Willard St.

Contractor: Paul's Plumbing Paul Walters

Address: 164 North St. Tel. 599-2431

NO. —

BLDG. PERMIT —

PERMIT FEE $ —

DATE PAID —

for office use only

LOCATION OF CONNECTION

Street and No. 1103 WILLARD Sanitary X Storm

Lot No. Subdivision HIGHLANDS 2ND Size of Tap 6"

Size and Type of Sewer PVC. ALL WORK MUST BE INSPECTED

I certify that the sewer will be used only as indicated and no other Drainage will be connected.

Date 6-11-79 Signature Laura Barnes

owner-builder agent

do not write below this line

INSPECTION RECORD

Date Inspected 6-11-79 Size and Type of Sewer 4" VIT

Location South of House to Alley Depth Type of Test N/A

Inspected and Approved By: Bruce Weinauch (Inspector) 6-11-79 (Date)

Additional Information SEPTIC TANK FILLED W/SAND

Send copy to: LAURA BARNES

SKETCH OF INSTALLATION

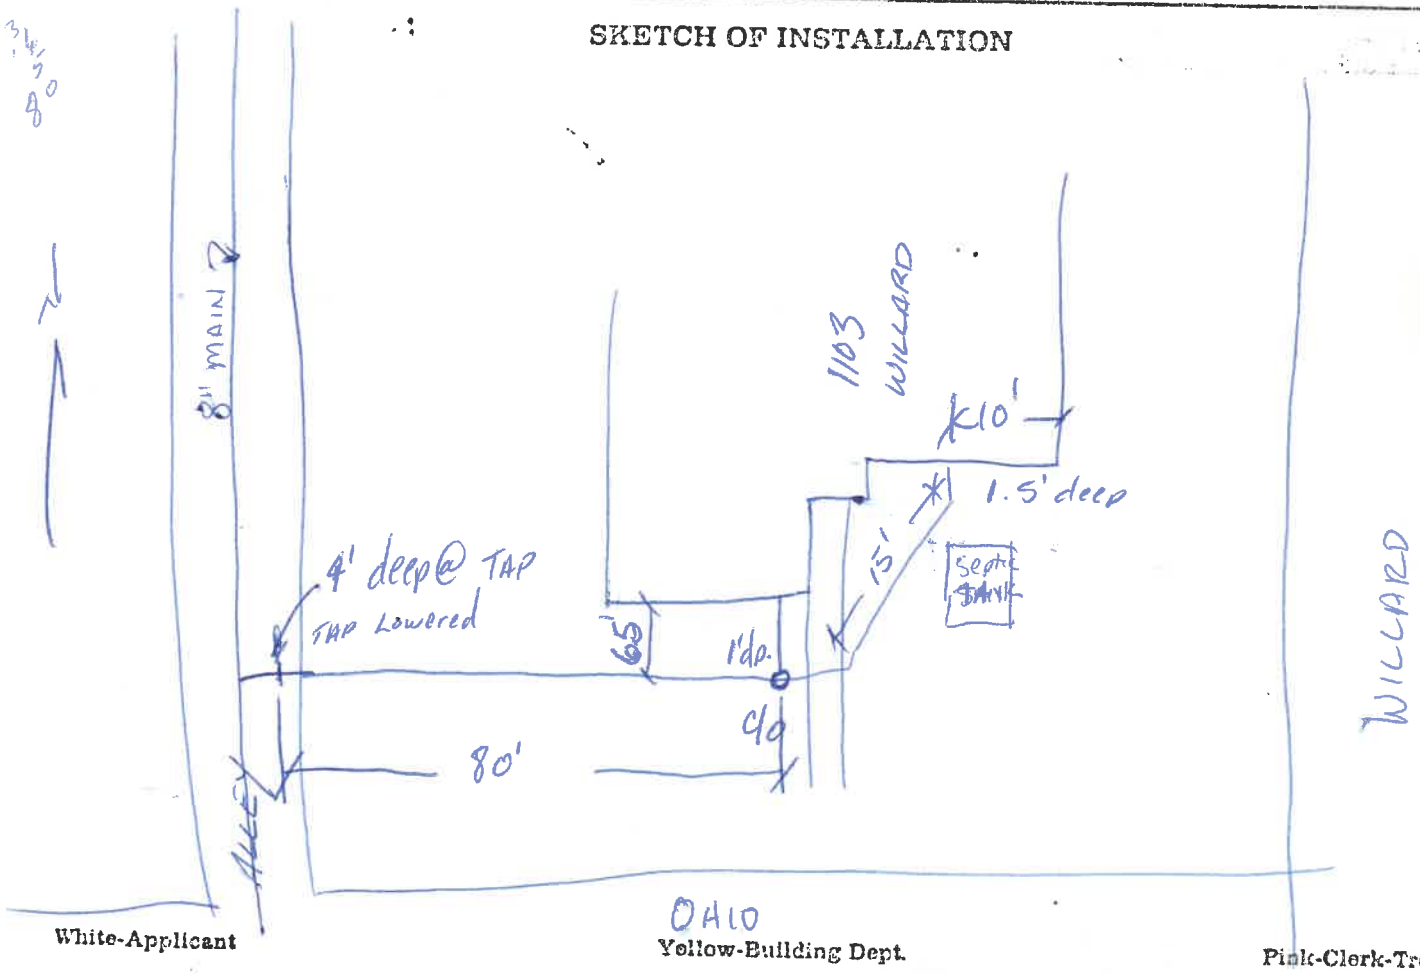

White-Applicant Yellow-Building Dept. Pink-Clerk-Treasurer